




7 CATWALK NO.1 ELEVATION
1/4" = 1'-0"

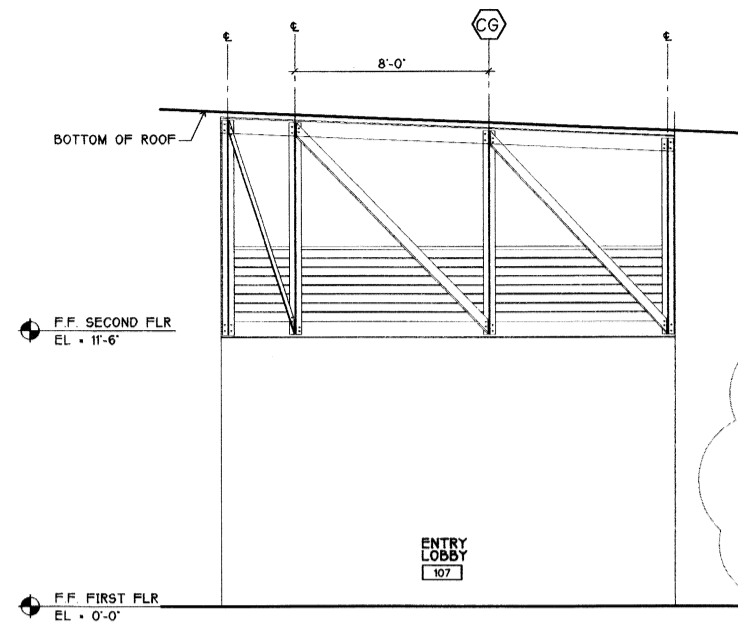


9 CATWALK NO.2 ELEVATION
1/4" = 1'-0"

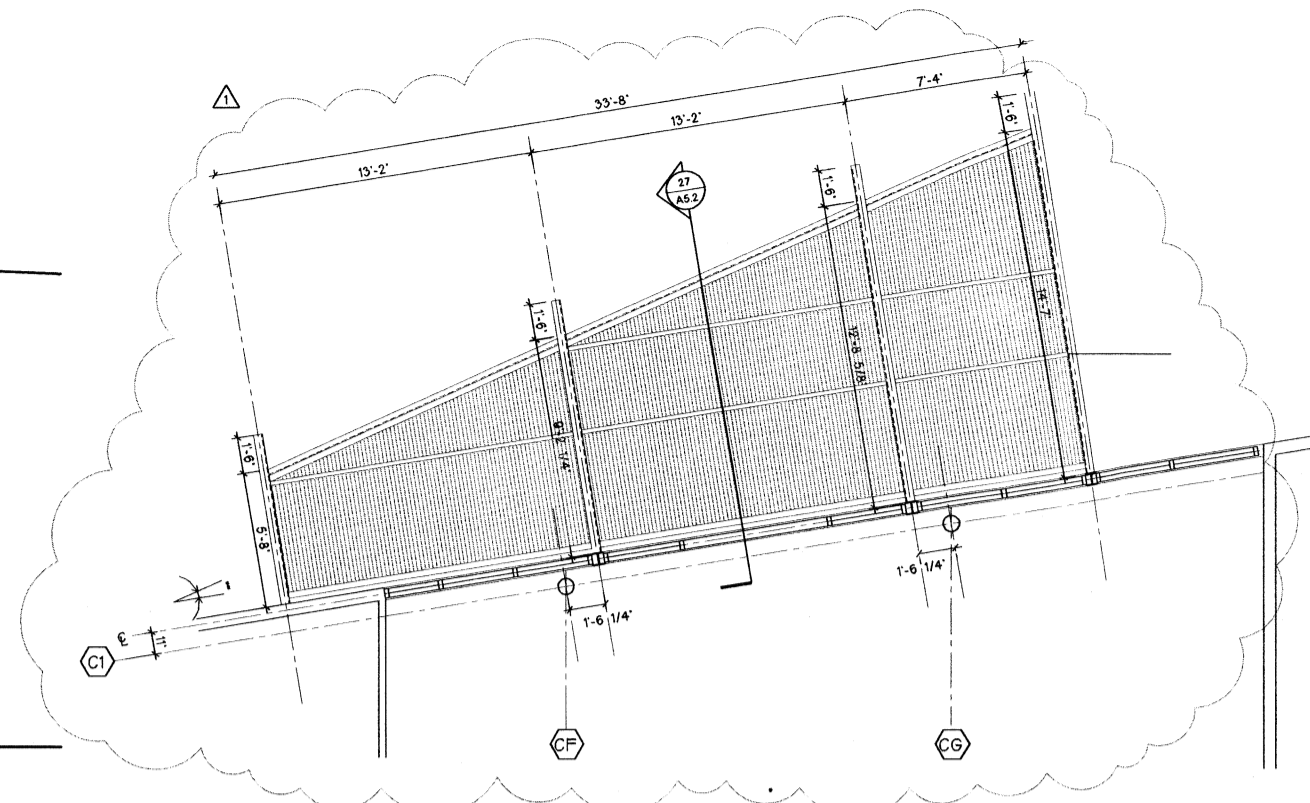

11 ENTRY CANOPY REFLECTED CEILING PLAN
1/4" = 1'-0"

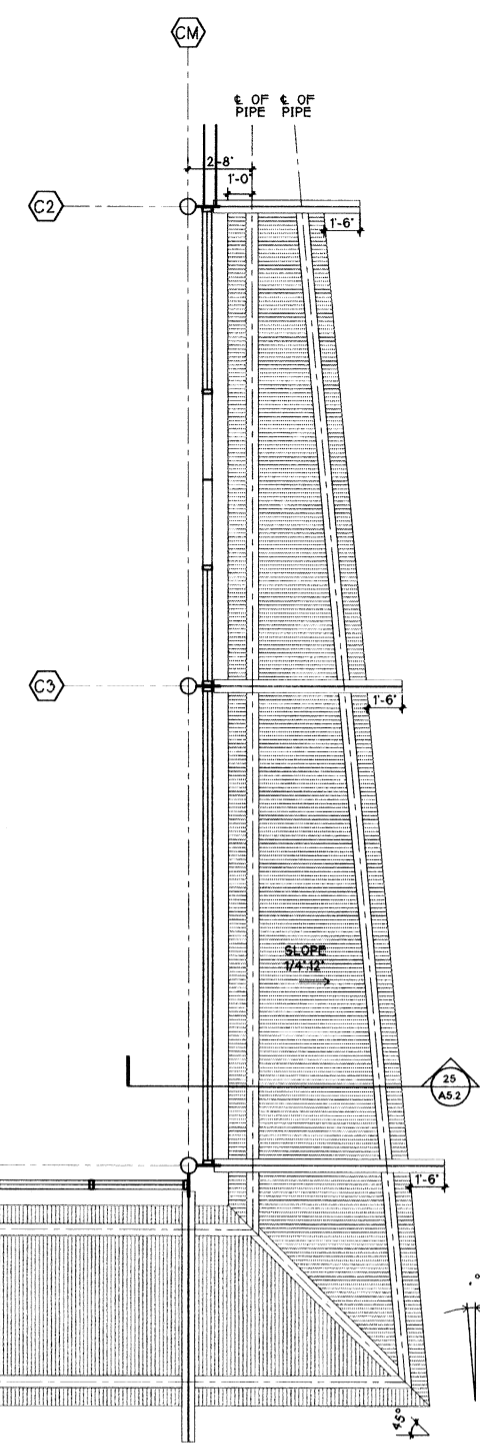


17 COURTYARD CANOPY REFLECTED CEILING PLAN
1/4" = 1'-0"

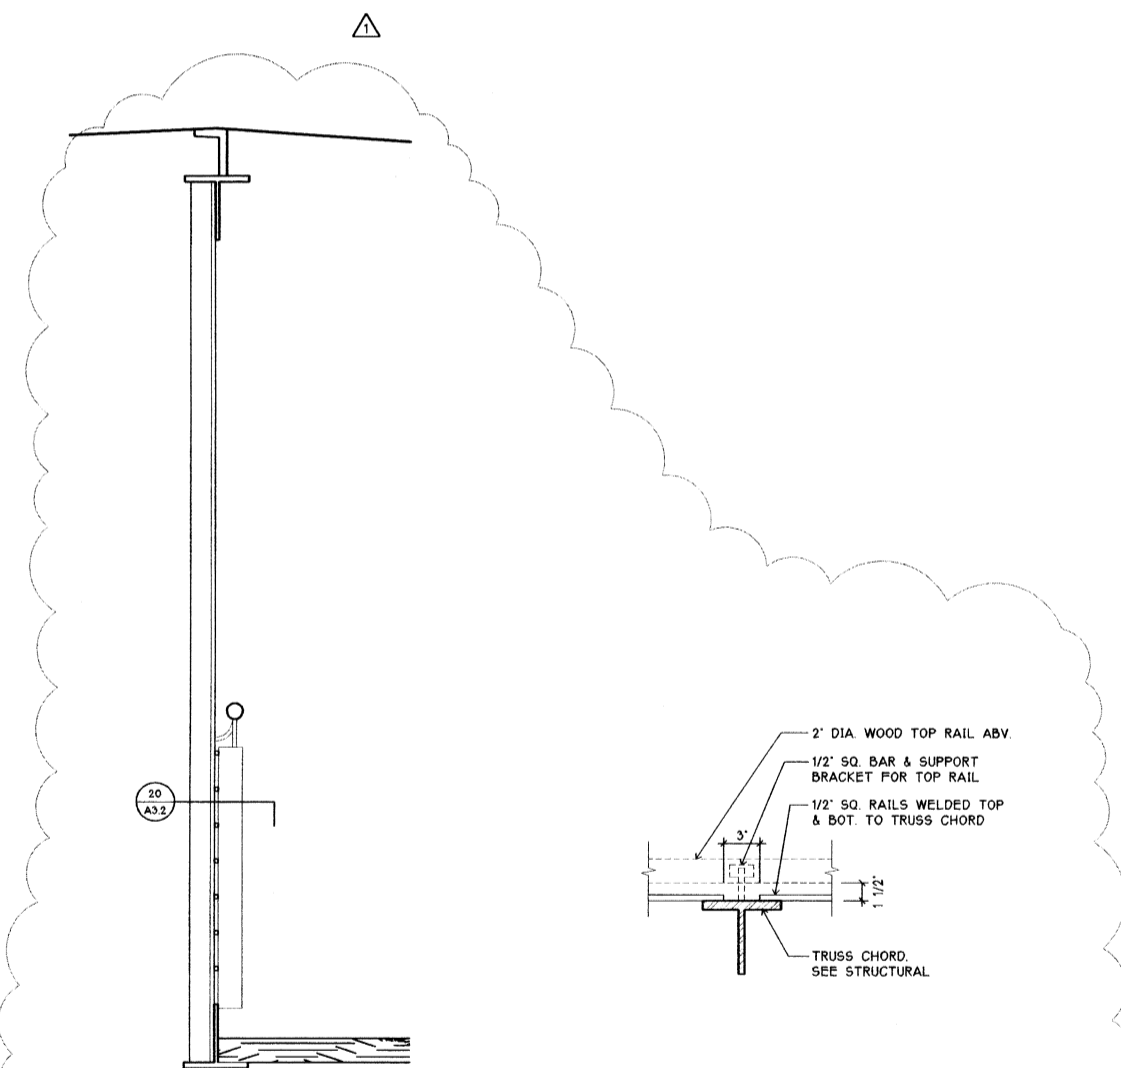


19 CATWALK NO. 1 SECTION
1" = 1'-0"


20 RAILING PLAN DETAIL
1 1/2" = 1'-0"

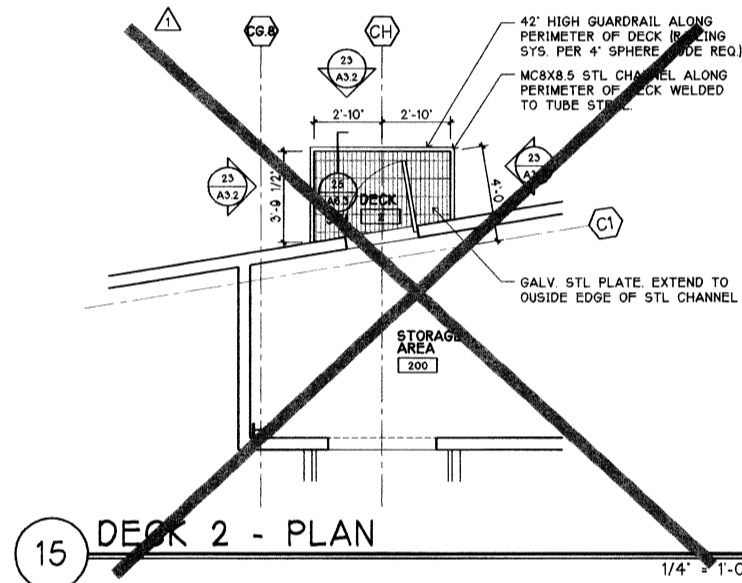


15 DECK 2 - PLAN
1/4" = 1'-0"

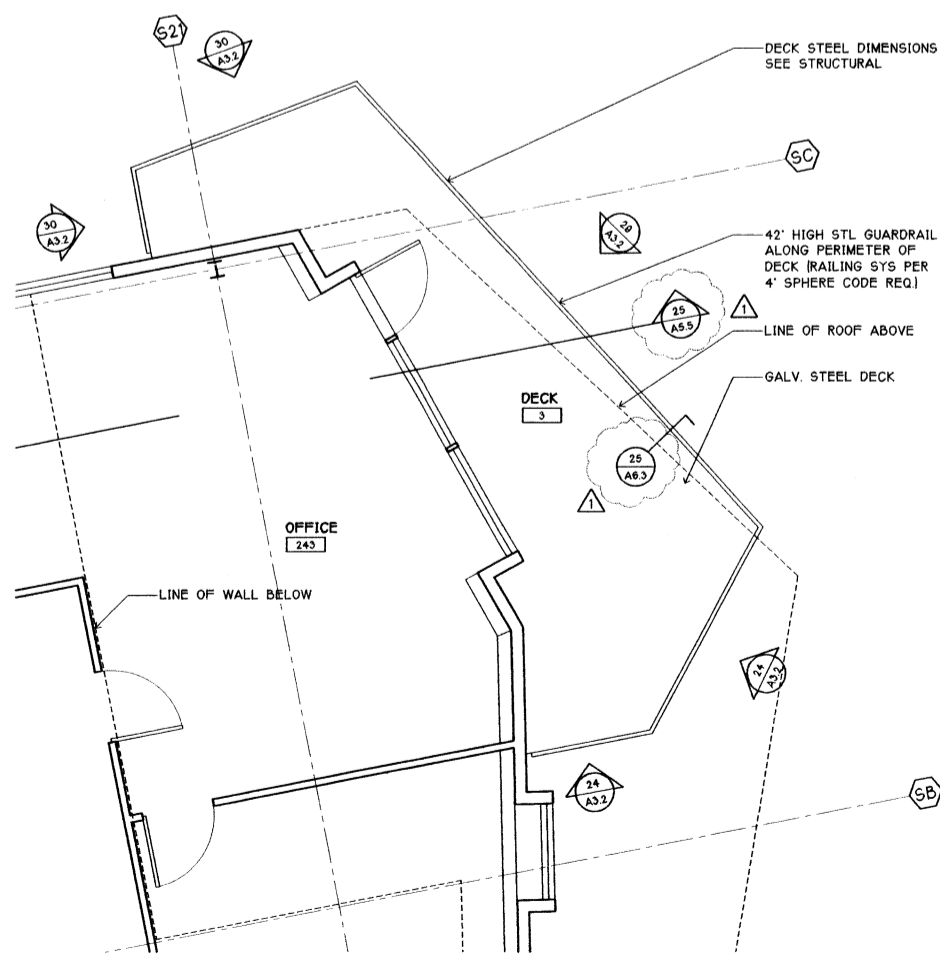


27 DECK 3 PLAN
1/4" = 1'-0"

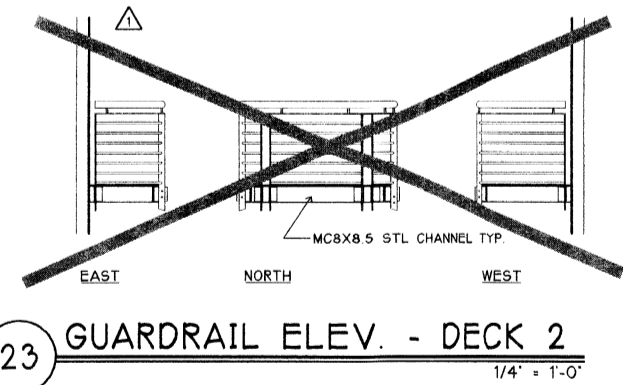


23 GUARDRAIL ELEV. - DECK 2
1/4" = 1'-0"

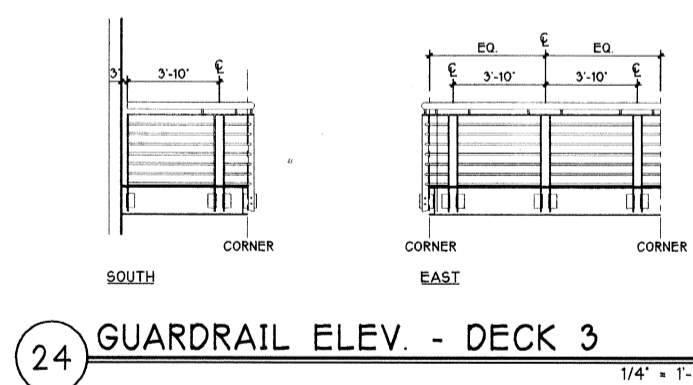

24 GUARDRAIL ELEV. - DECK 3
1/4" = 1'-0"

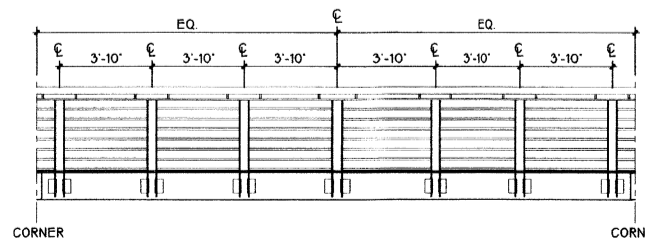

29 GUARDRAIL ELEV. - DECK 3
1/4" = 1'-0"

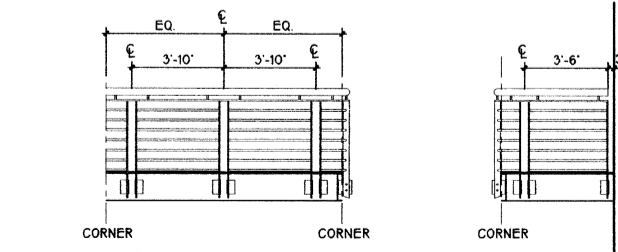

30 GUARDRAIL ELEV. - DECK 3
1/4" = 1'-0"

DATE	REVISION
5/18/99	CONSTRU. SET
BG	DRAWN BY
RF	CHECKED BY
DAS/DWG	PROJECT MANAGER
CHH / KT	PROJECT ARCHITECT
FB	DATE
DEP	