
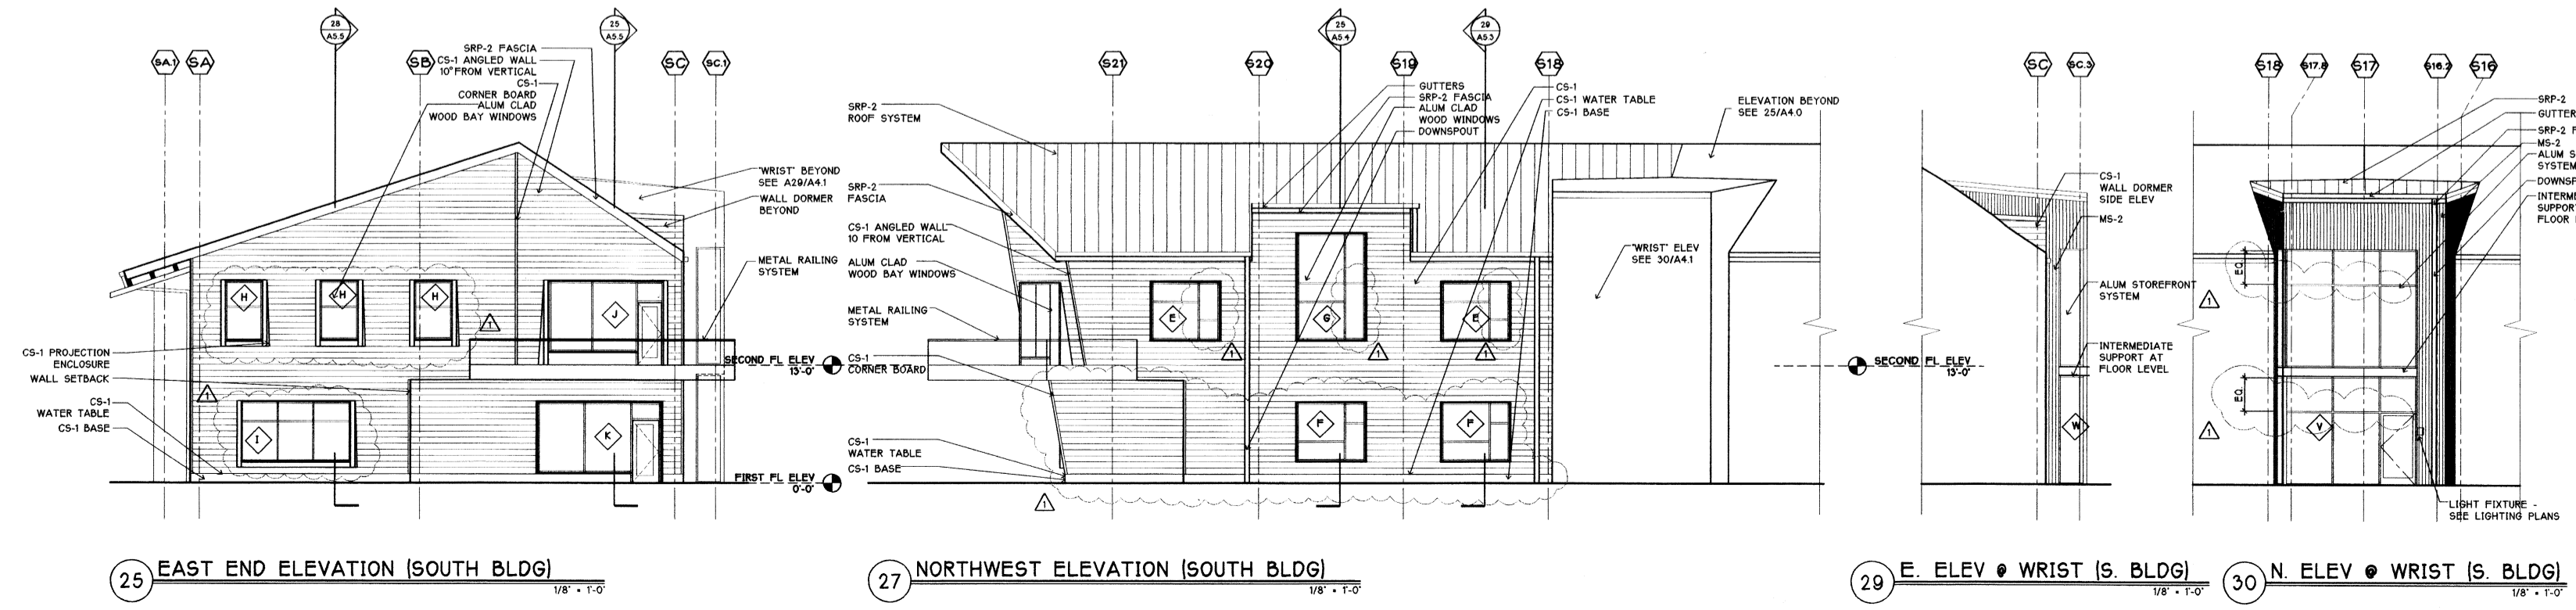
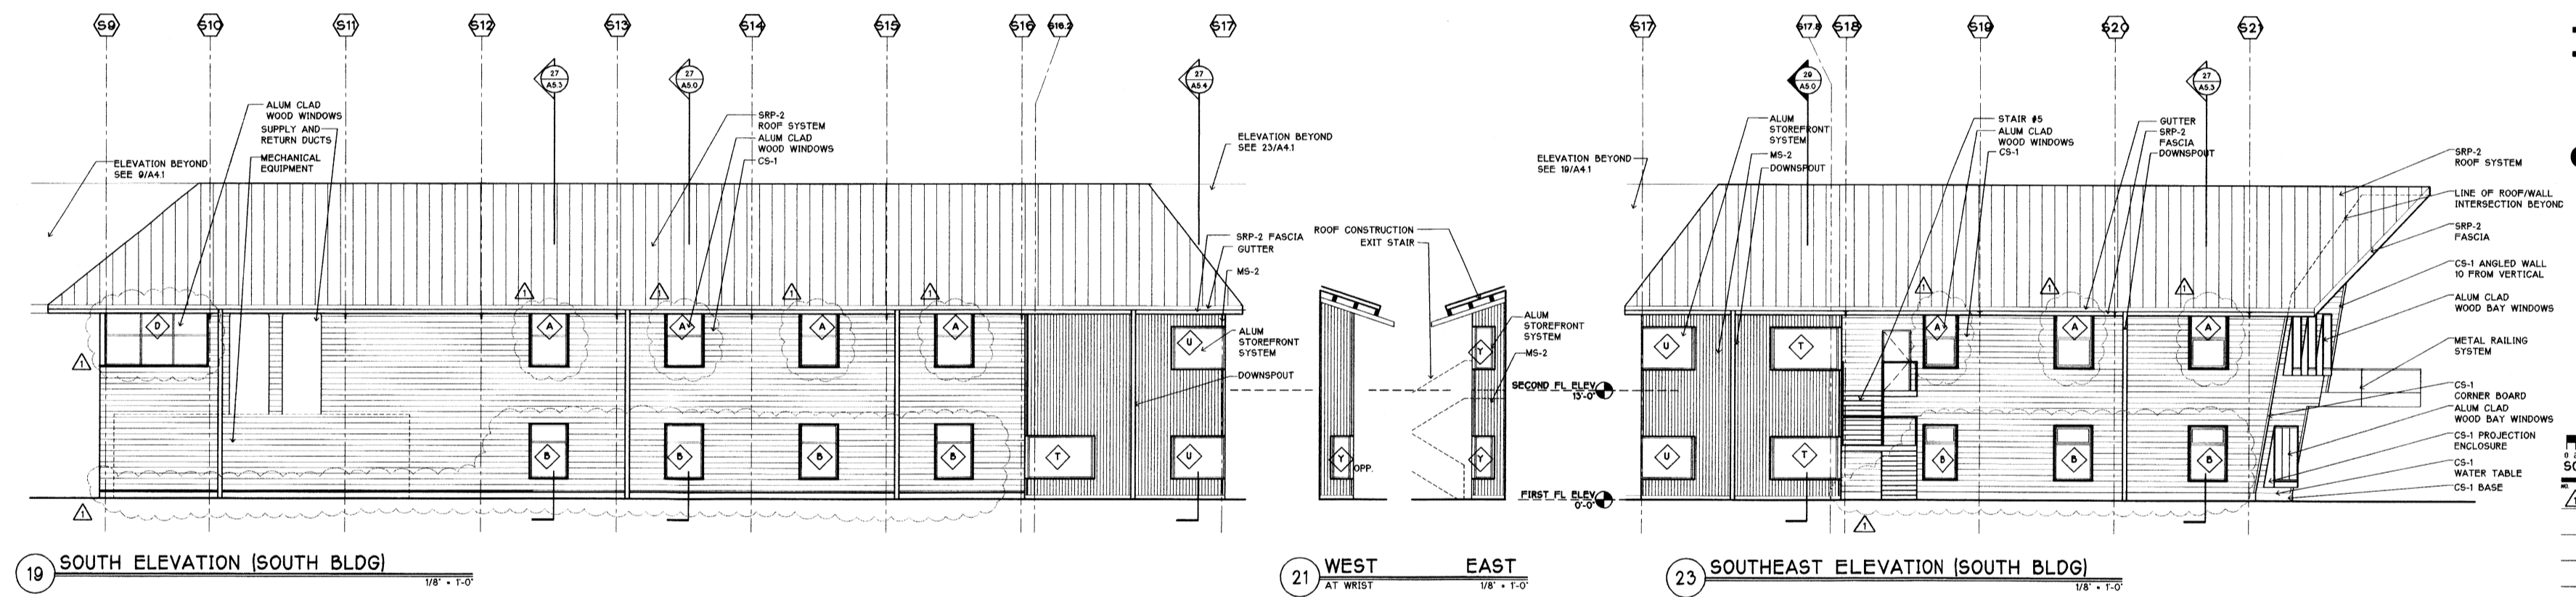
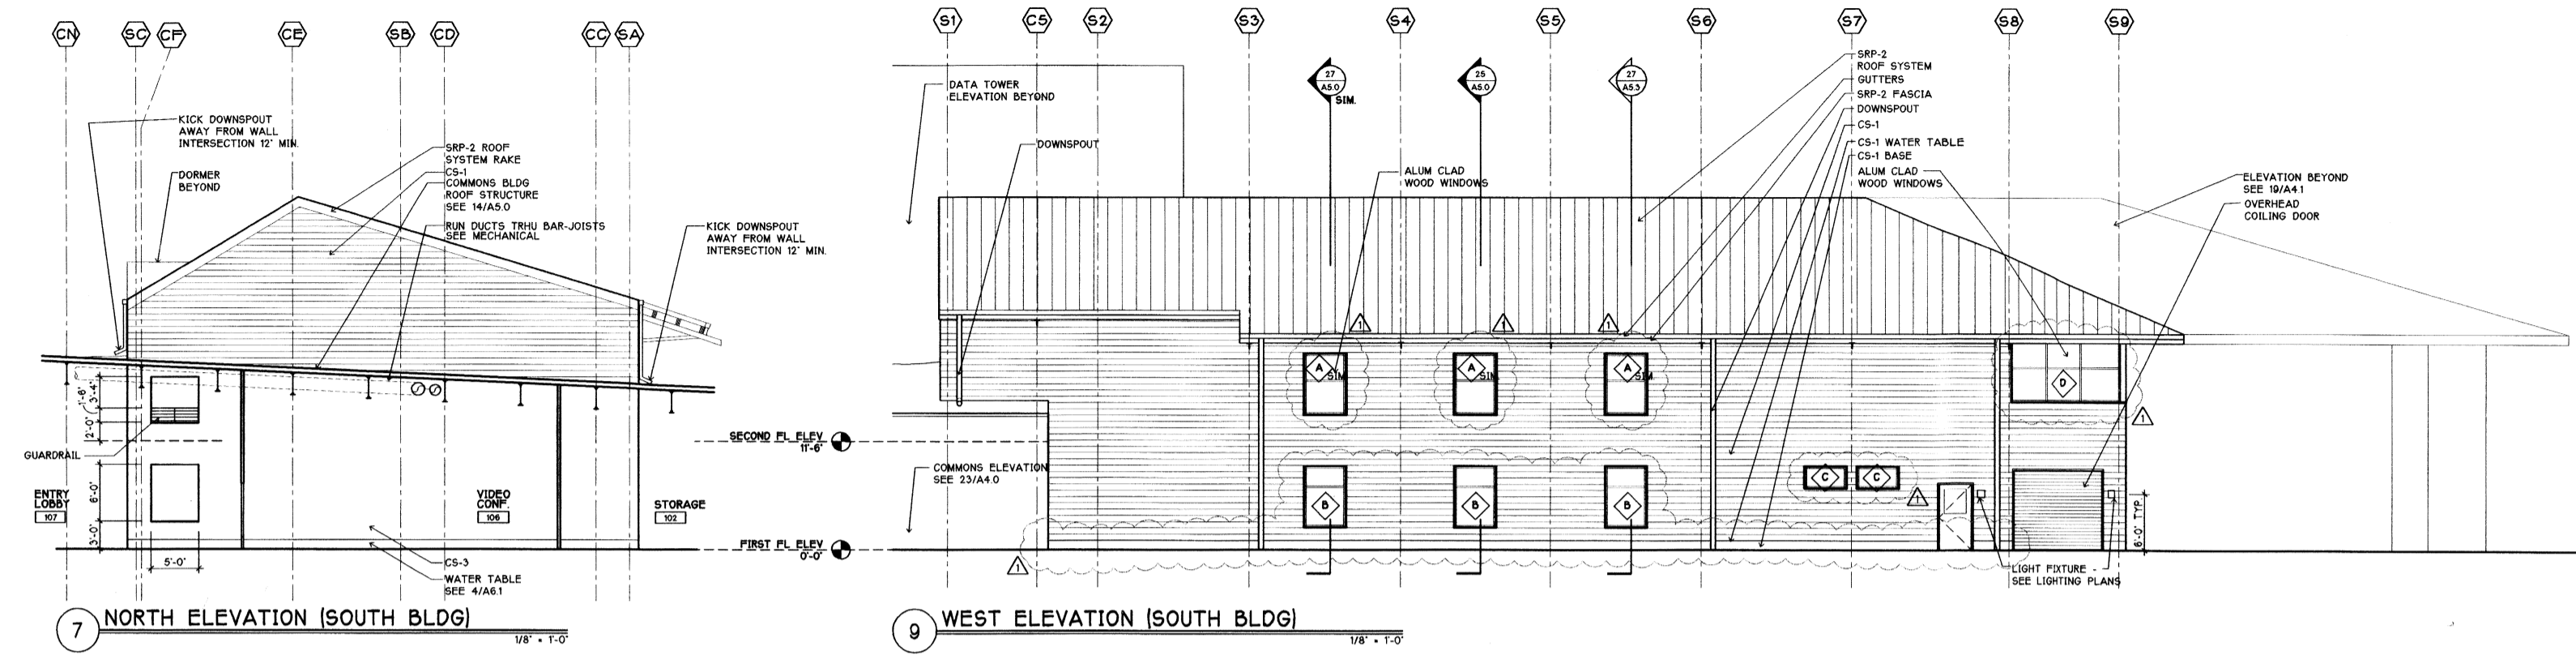


SUN HEALTHCARE SYSTEMS, INC.
CAMPUS: PHASE ONE
ANACORTES, WASHINGTON

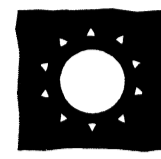

SCALE 1/8"=1'-0"
 DATE 5/18/99
 CONSTRU SET

BG
 RF
 DAS/DWG
 DWG/SKC
 FB

2029 REGISTERED ARCHITECT
 THOMAS D. EMERSON
 STATE OF WASHINGTON

EXTERIOR ELEVATIONS
 08060.05
 MAY 18, 1999
 E:\08060\CD\A4-1

M.1 CONSTRUCTION SET