



7 DUMPSTER PAD - PLAN
1/4" = 1'-0"

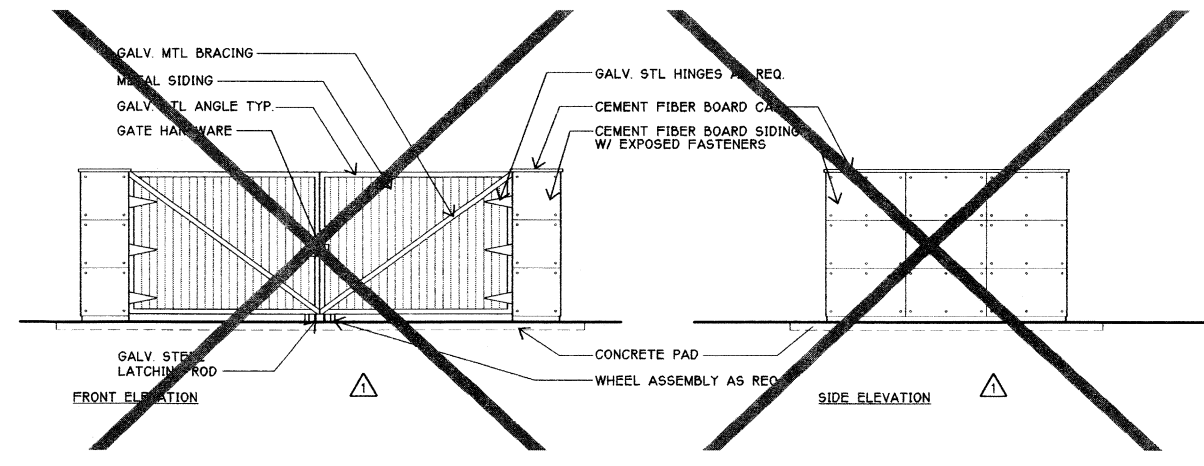


8 DUMPSTER ENCLOSURE ELEVATION
1/4" = 1'-0"


9 DUMPSTER ENCLOSURE ELEVATION
1/4" = 1'-0"

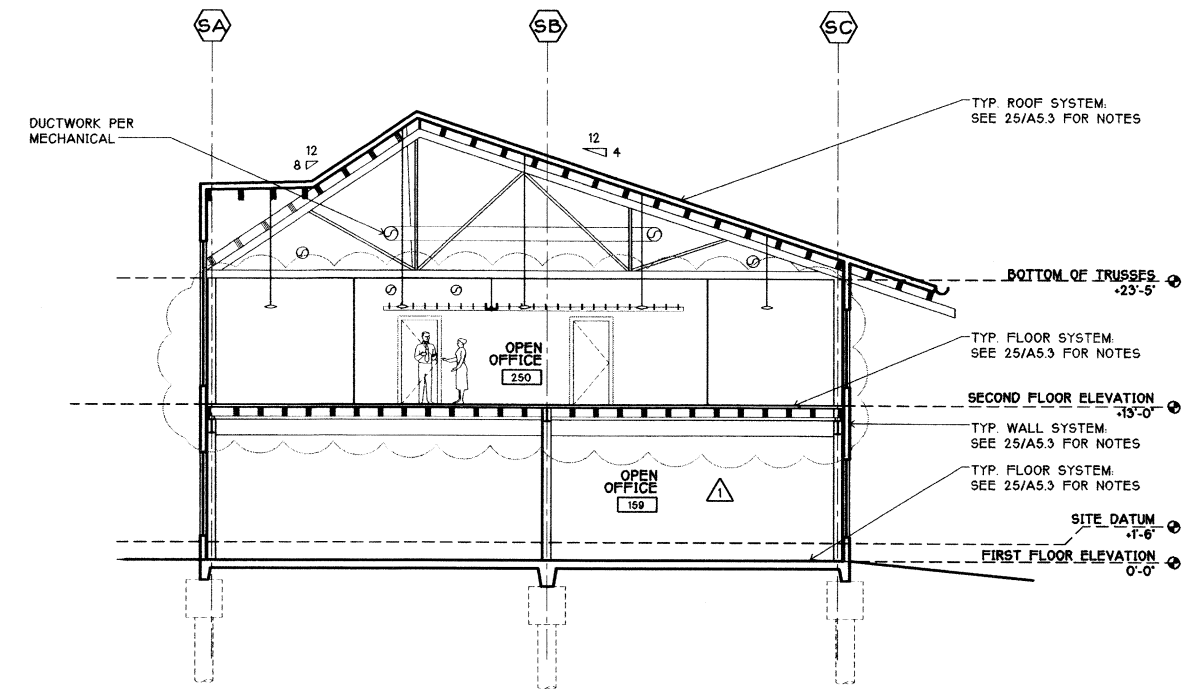

11 BUILDING SECTION THRU EXECUTIVE WING
1/8" = 1'-0"

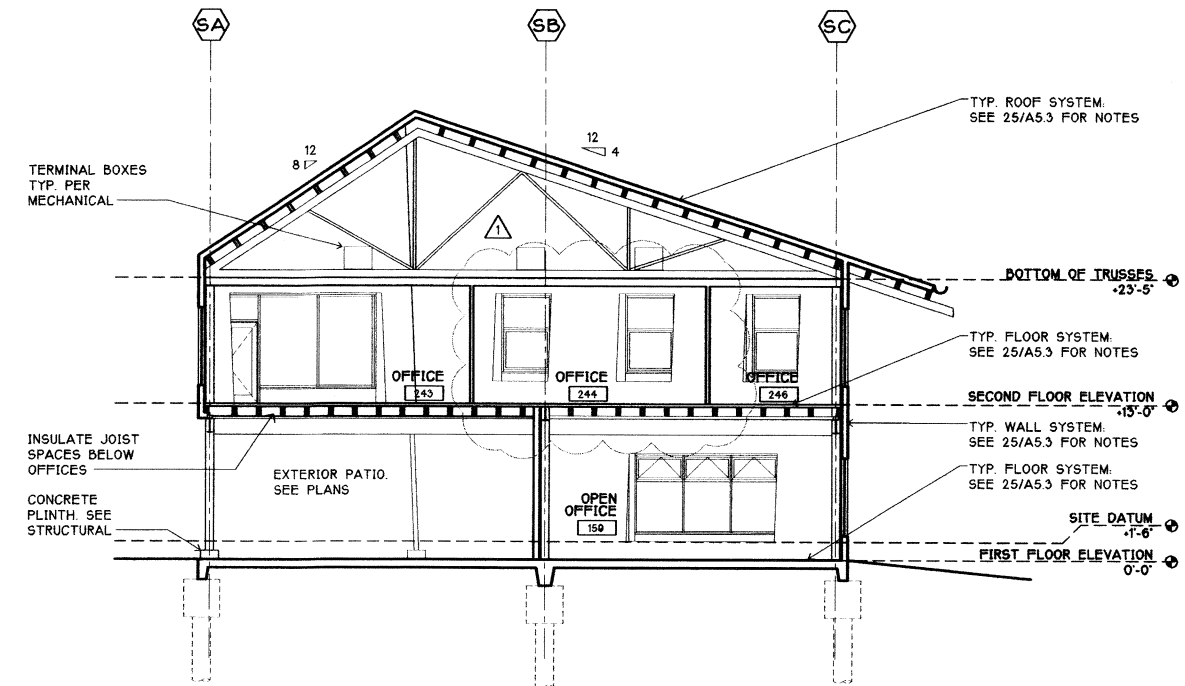

23 BUILDING SECTION THRU EXECUTIVE WING
1/8" = 1'-0"

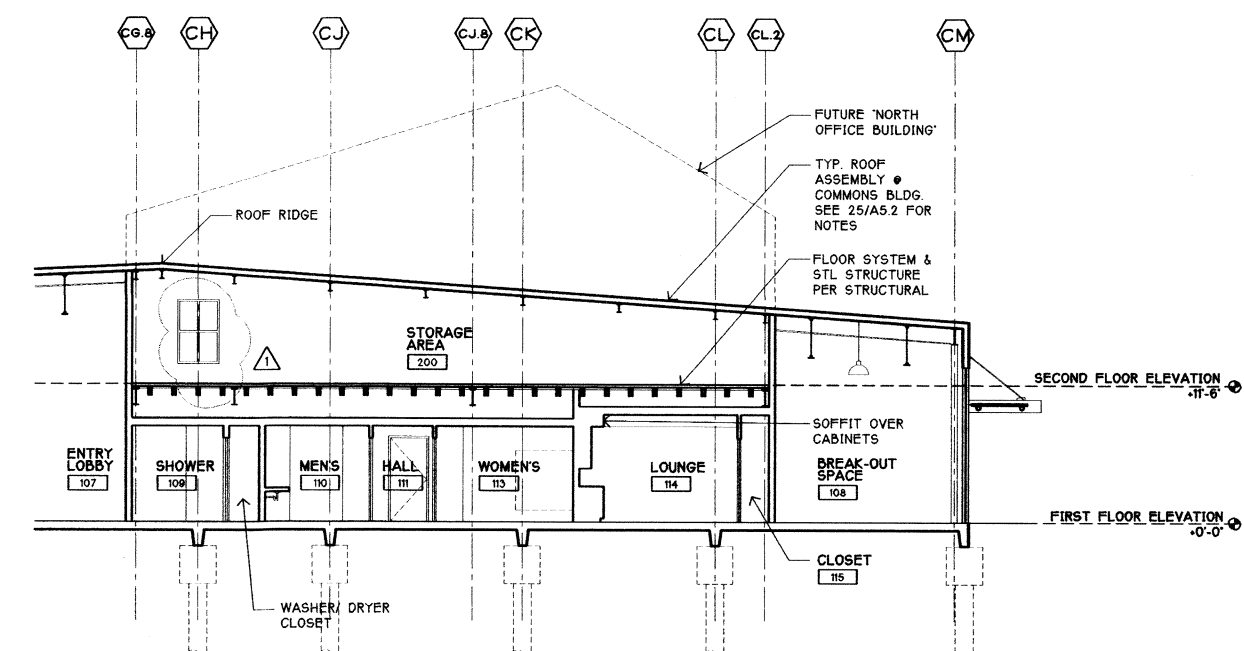

28 SECTION THRU COMMONS CORE
1/8" = 1'-0"