

SUN HEALTHCARE SYSTEMS, INC.

CAMPUS: PHASE ONE
ANACORTES, WASHINGTON

SCALE 3/4"=1'-0"

DATE: 5/18/99
REVISION: CONSTRU. SET


BY: BG
CHECKED BY: RF
PROJECT NUMBER: DAS/DWG
PROJECT ARCHITECT: CH/DWG
DESIGNER: FB
DATE:

2029 REGISTERED ARCHITECT
THOMAS D. ENRICH
STATE OF WASHINGTON

WALL SECTIONS
COMMON BLDG &
DATA TOWER

98060.05
PROJECT NO.
MAY 18, 1999
DATE
E:\98060\CD\A5-2
DRAWING FILE NAME

A5.2 CONSTRUCTION SET

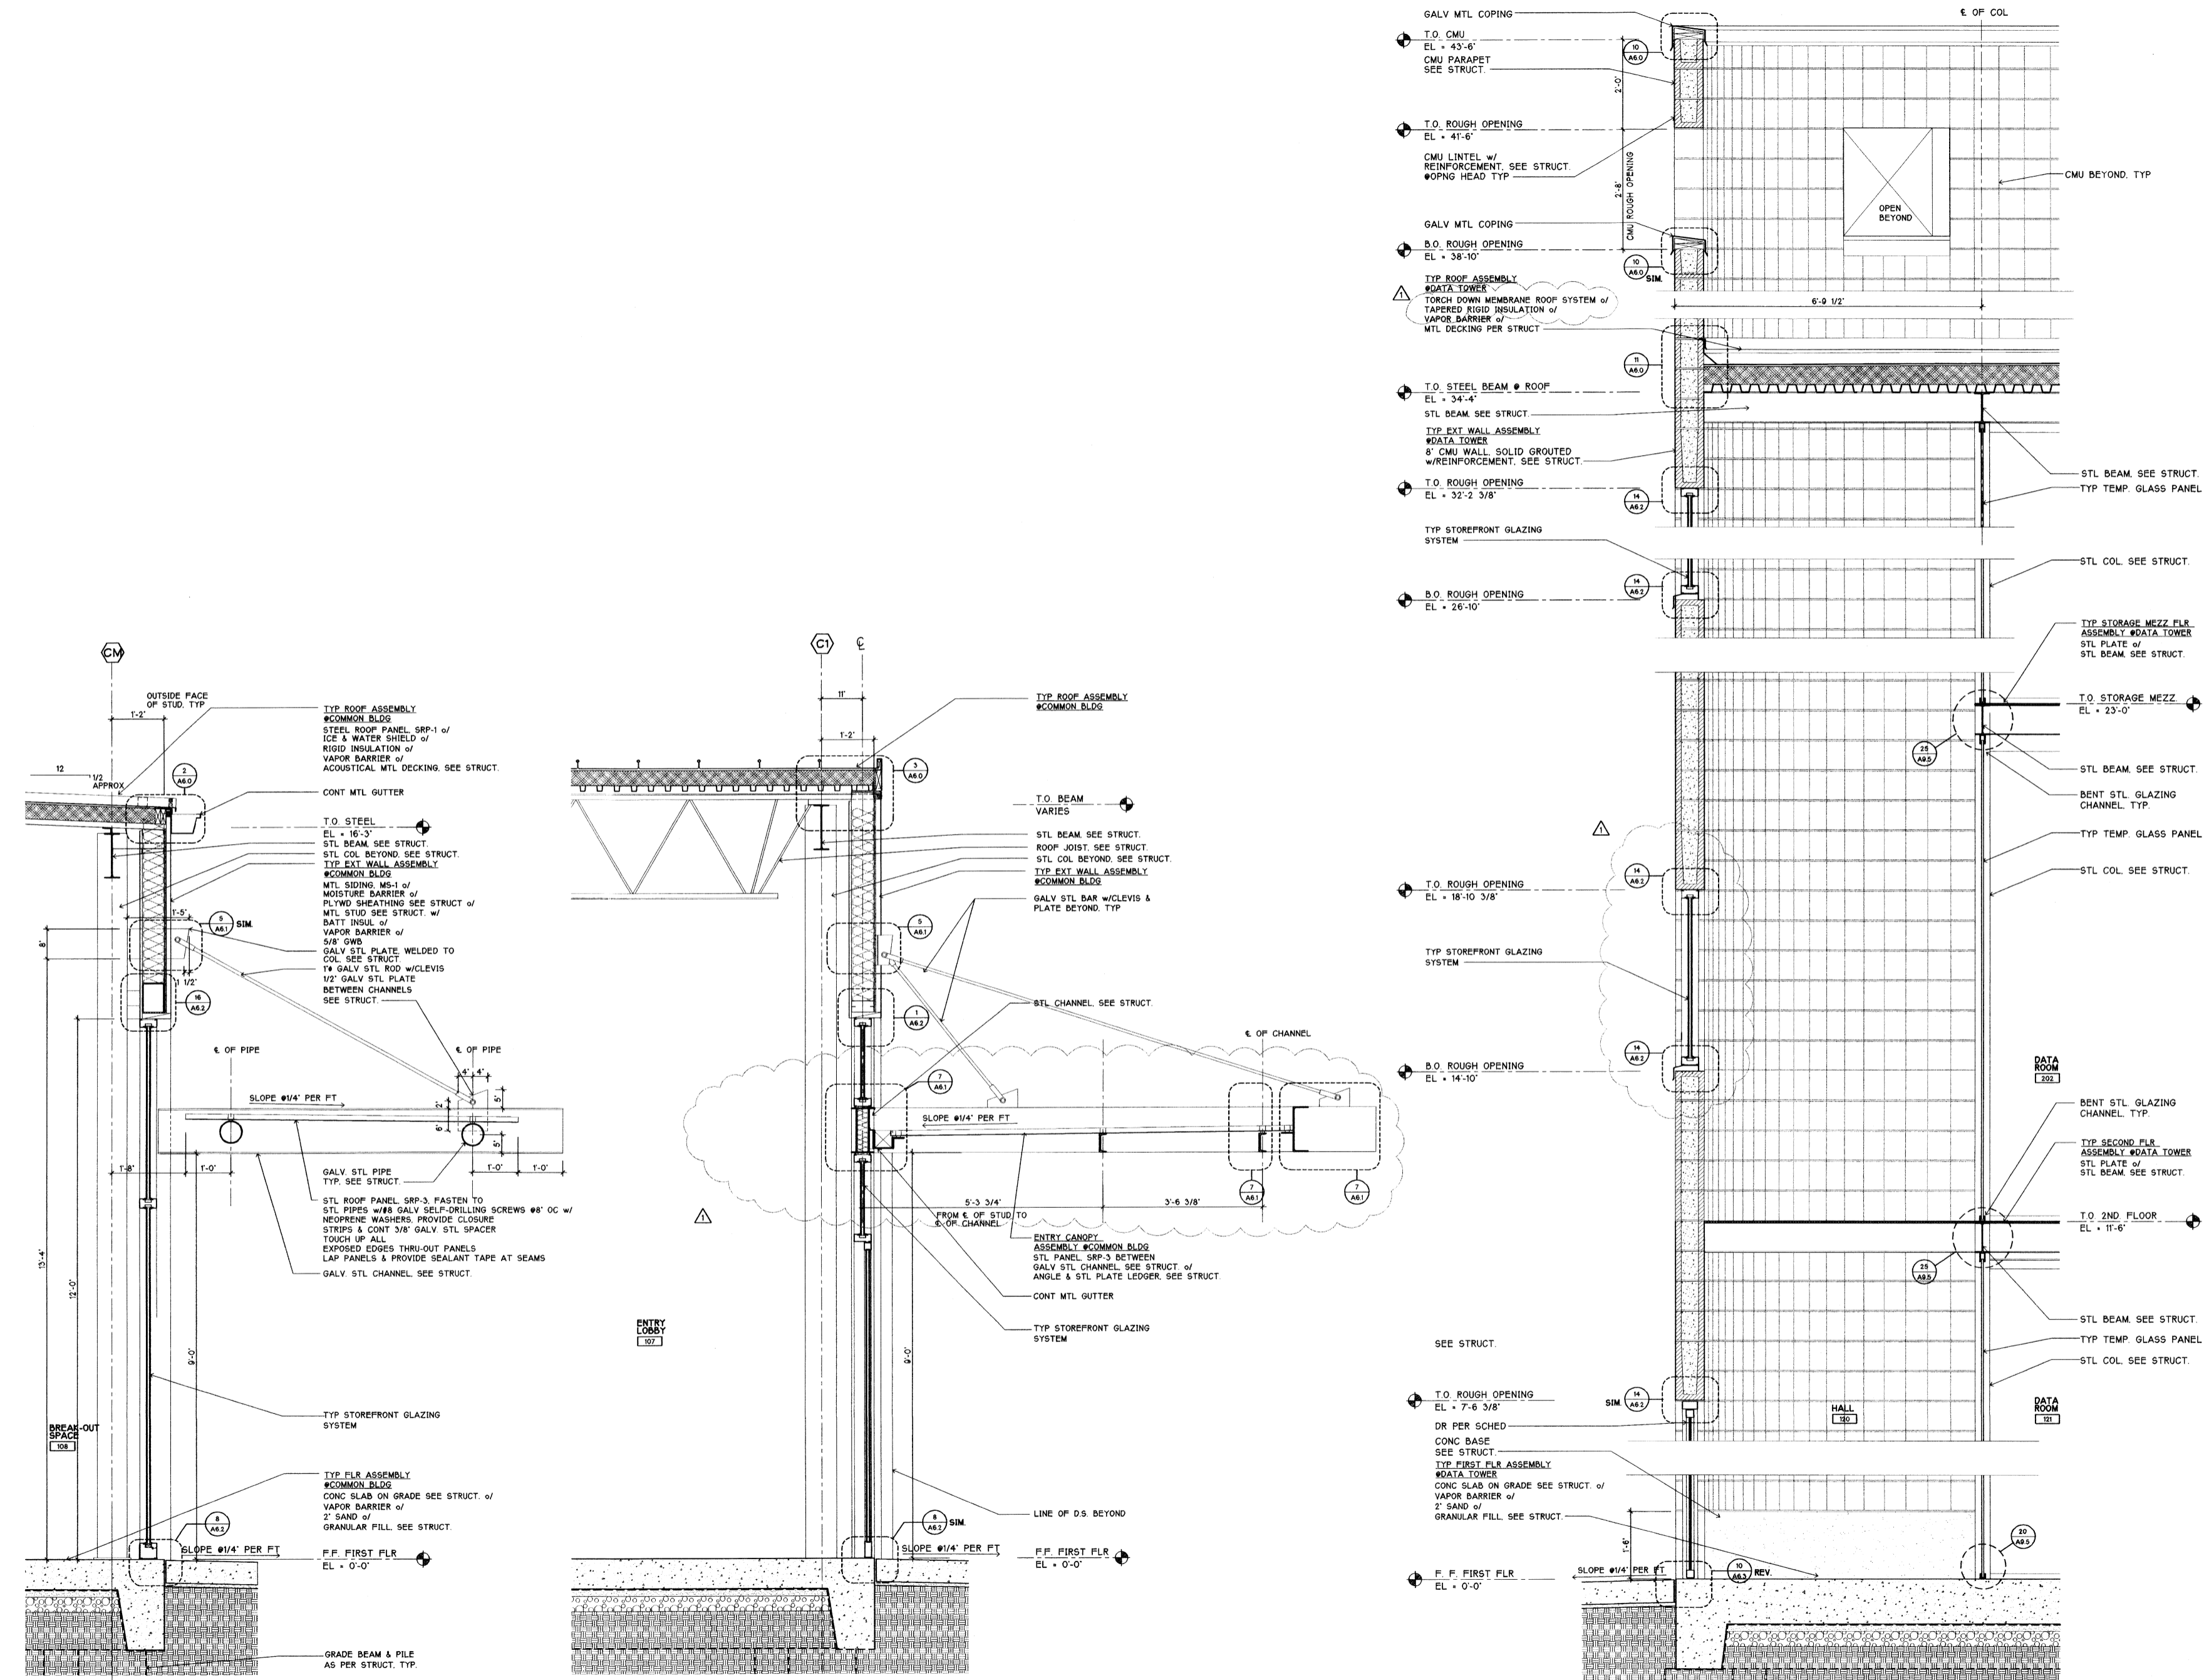

25 WALL SECTION • EAST WALL, COMMON BLDG

27 WALL SECTION • ENTRY, COMMON BLDG

29 WALL SECTION • DATA TOWER

3/4" = 1'-0"

NOTE: SEE 25/A5.2 FOR TYP NOTES & DIMS.

NOTE: SEE 25/A5.2 FOR TYP NOTES & DIMS.

3/4" = 1'-0"