

SUN HEALTHCARE SYSTEMS, INC.
CAMPUS: PHASE ONE
ANACORTES, WASHINGTON

SCALE 3/4"=1'-0"

5/18/99 CONSTRU SET


BG
 PARTNER IN CHARGE
 RF
 PROJECT ARCHITECT
 CHH
 DESIGNER
 FB
 CHECKER

2029 REGISTERED ARCHITECT
 THOMAS D. ENRICH
 STATE OF WASHINGTON


WALL SECTIONS
 AT OFFICE BLDG

98060.05
 PROJECT NO.
 MAY 18, 1999
 DATE
 E:\98060\CD\A5-3
 DRAWING FILE NAME


A5.3 CONSTRUCTION SET

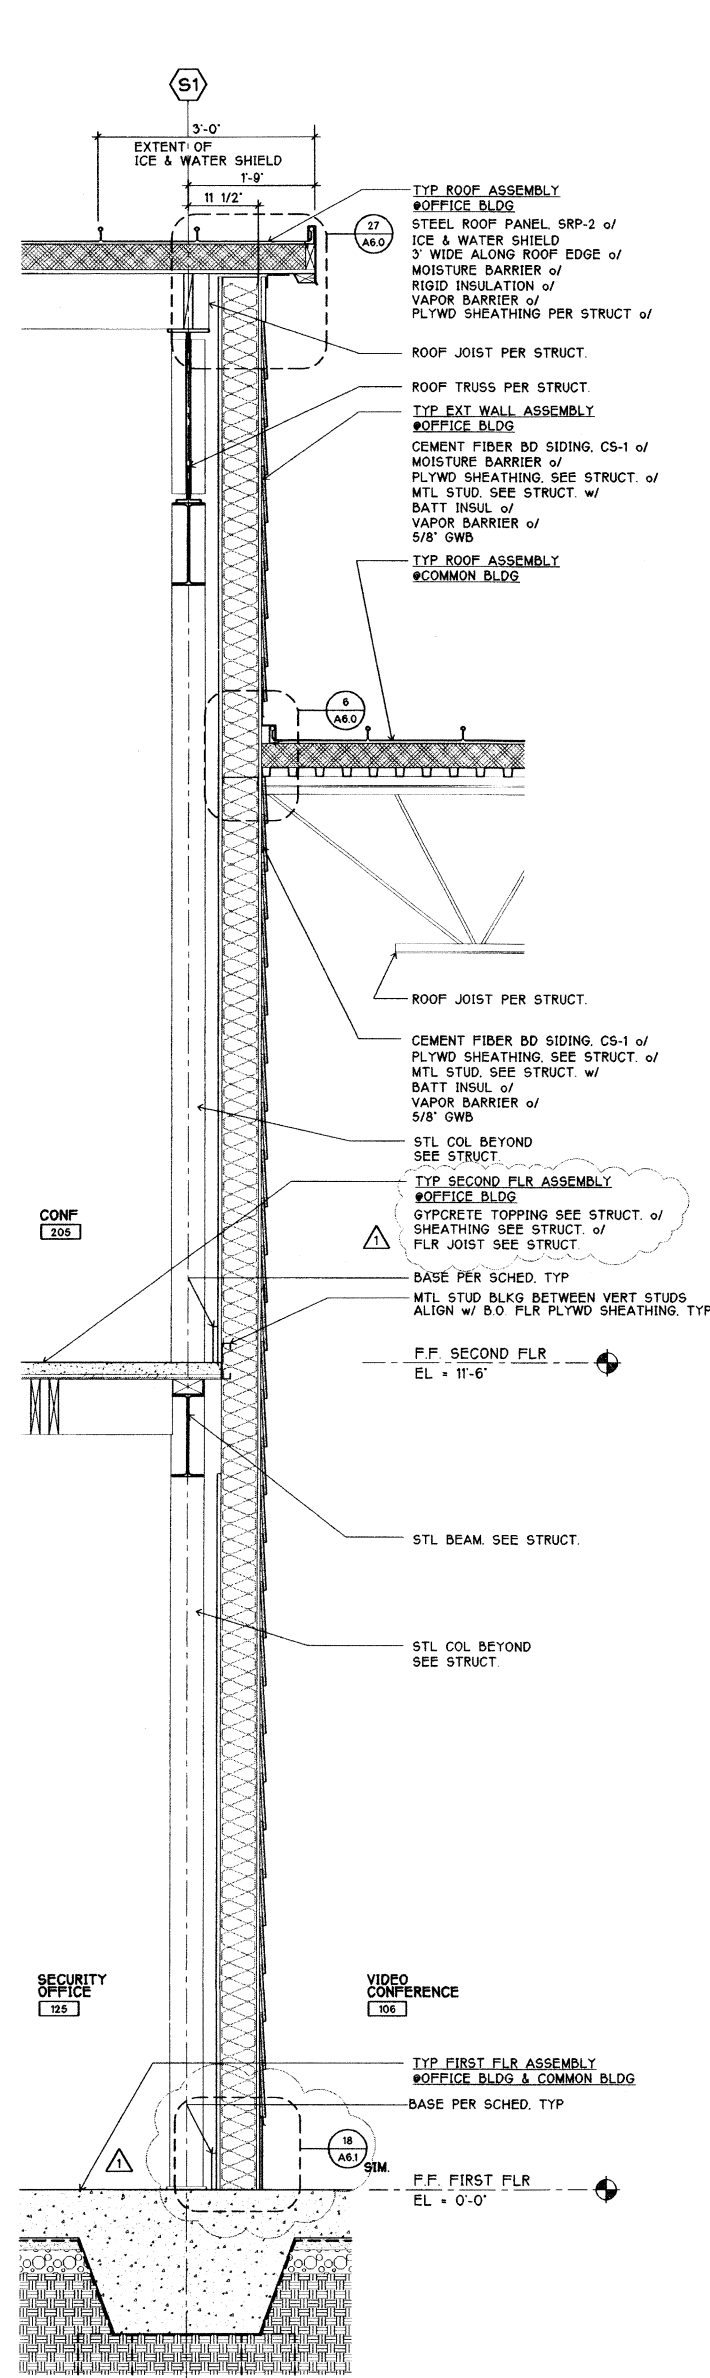

25 WALL SECTION @COMMON BLDG&OFFICE BLDG
 NOTE: SEE 25/A5.2 FOR TYP NOTES & DIMS 3/4"=1'-0"

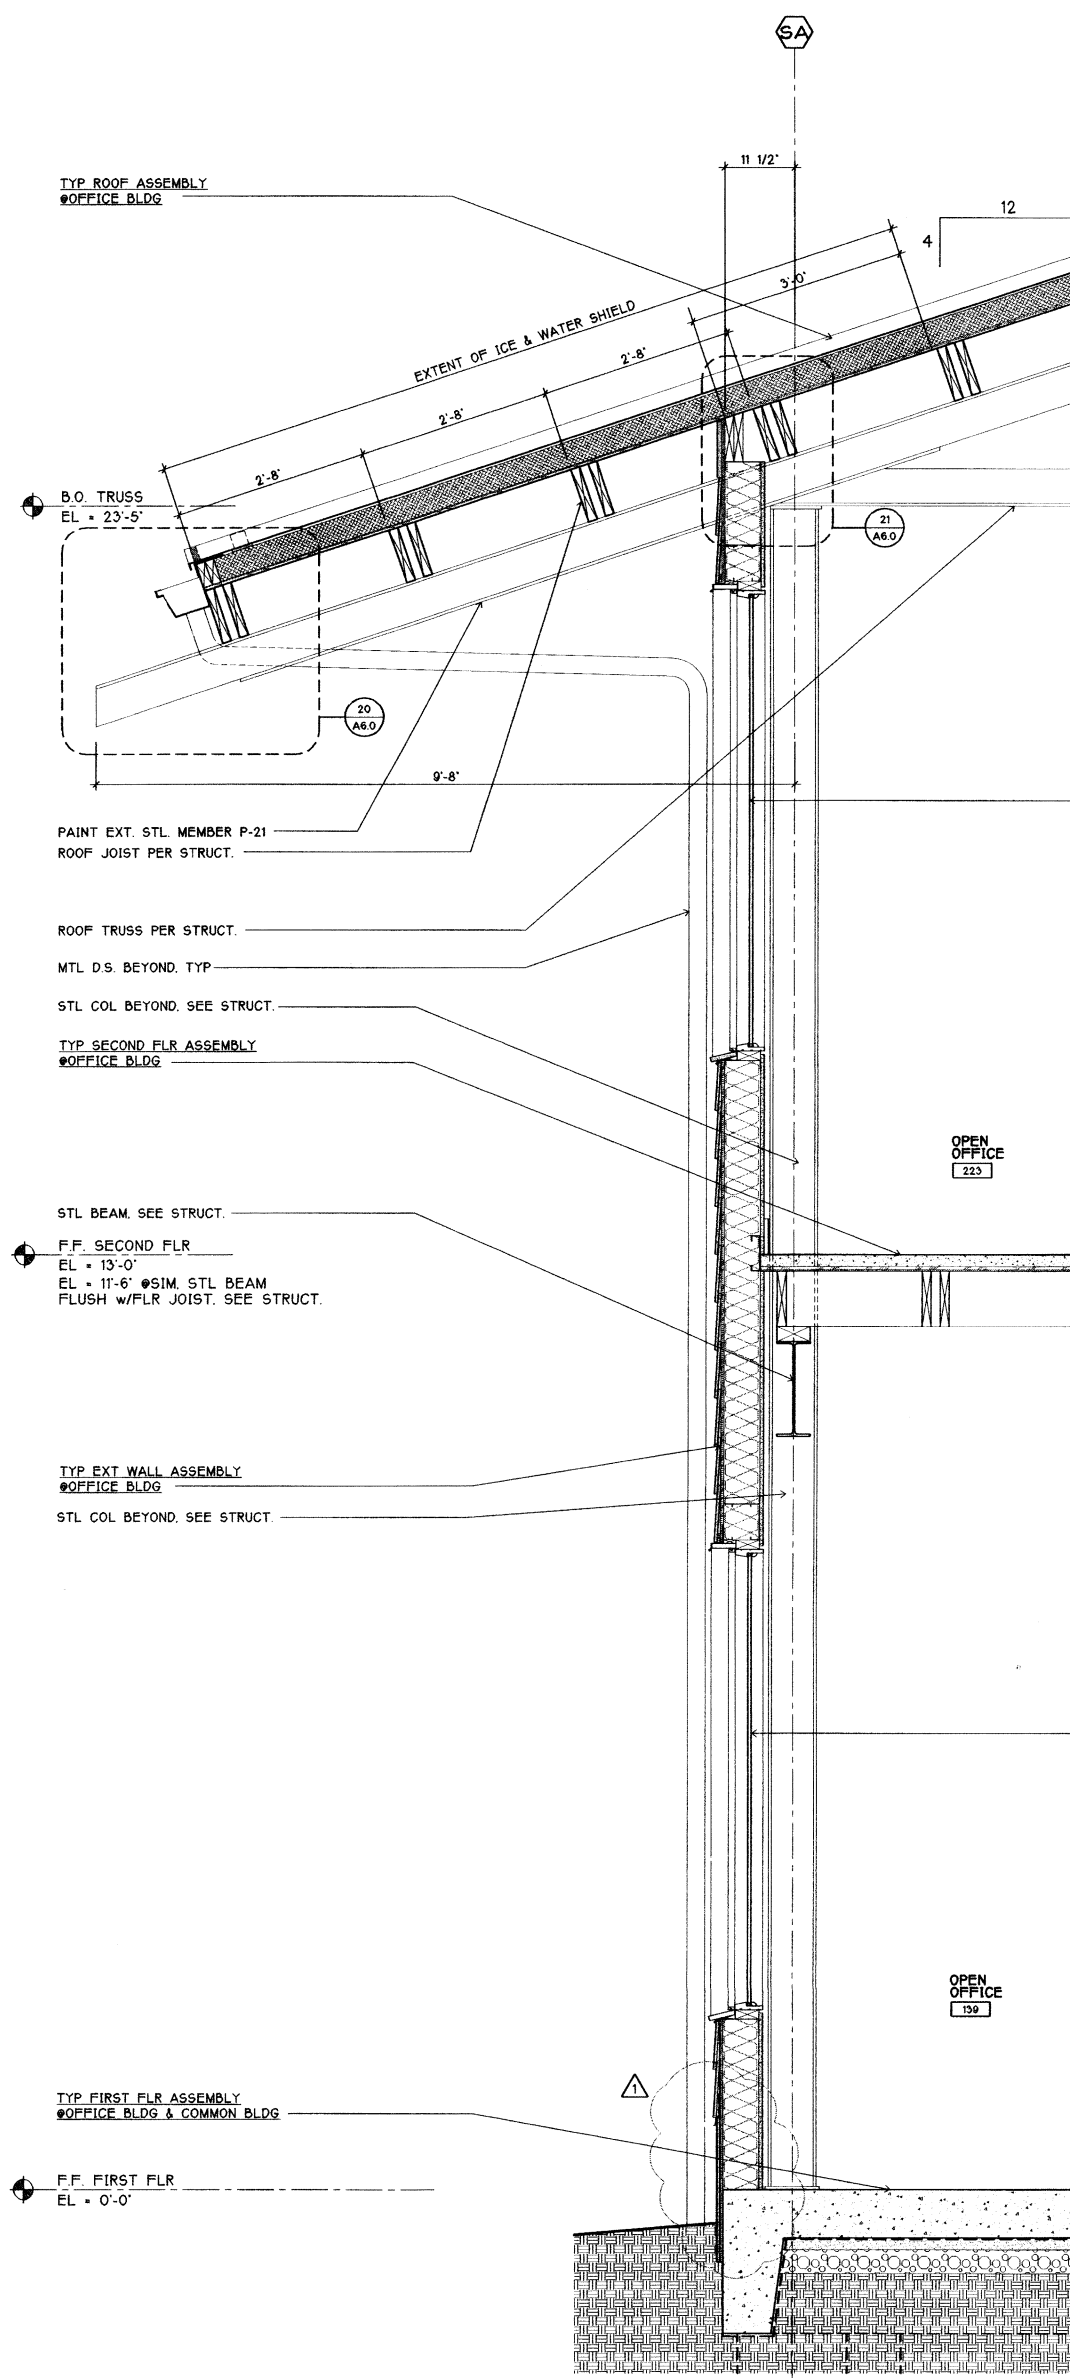

27 WALL SECTION THRU ROOF OVERHANG @ OFFICE BLDG
 NOTE: SEE 25/A5.2 & 25/A5.3 FOR TYP NOTES & DIMS 3/4"=1'-0"

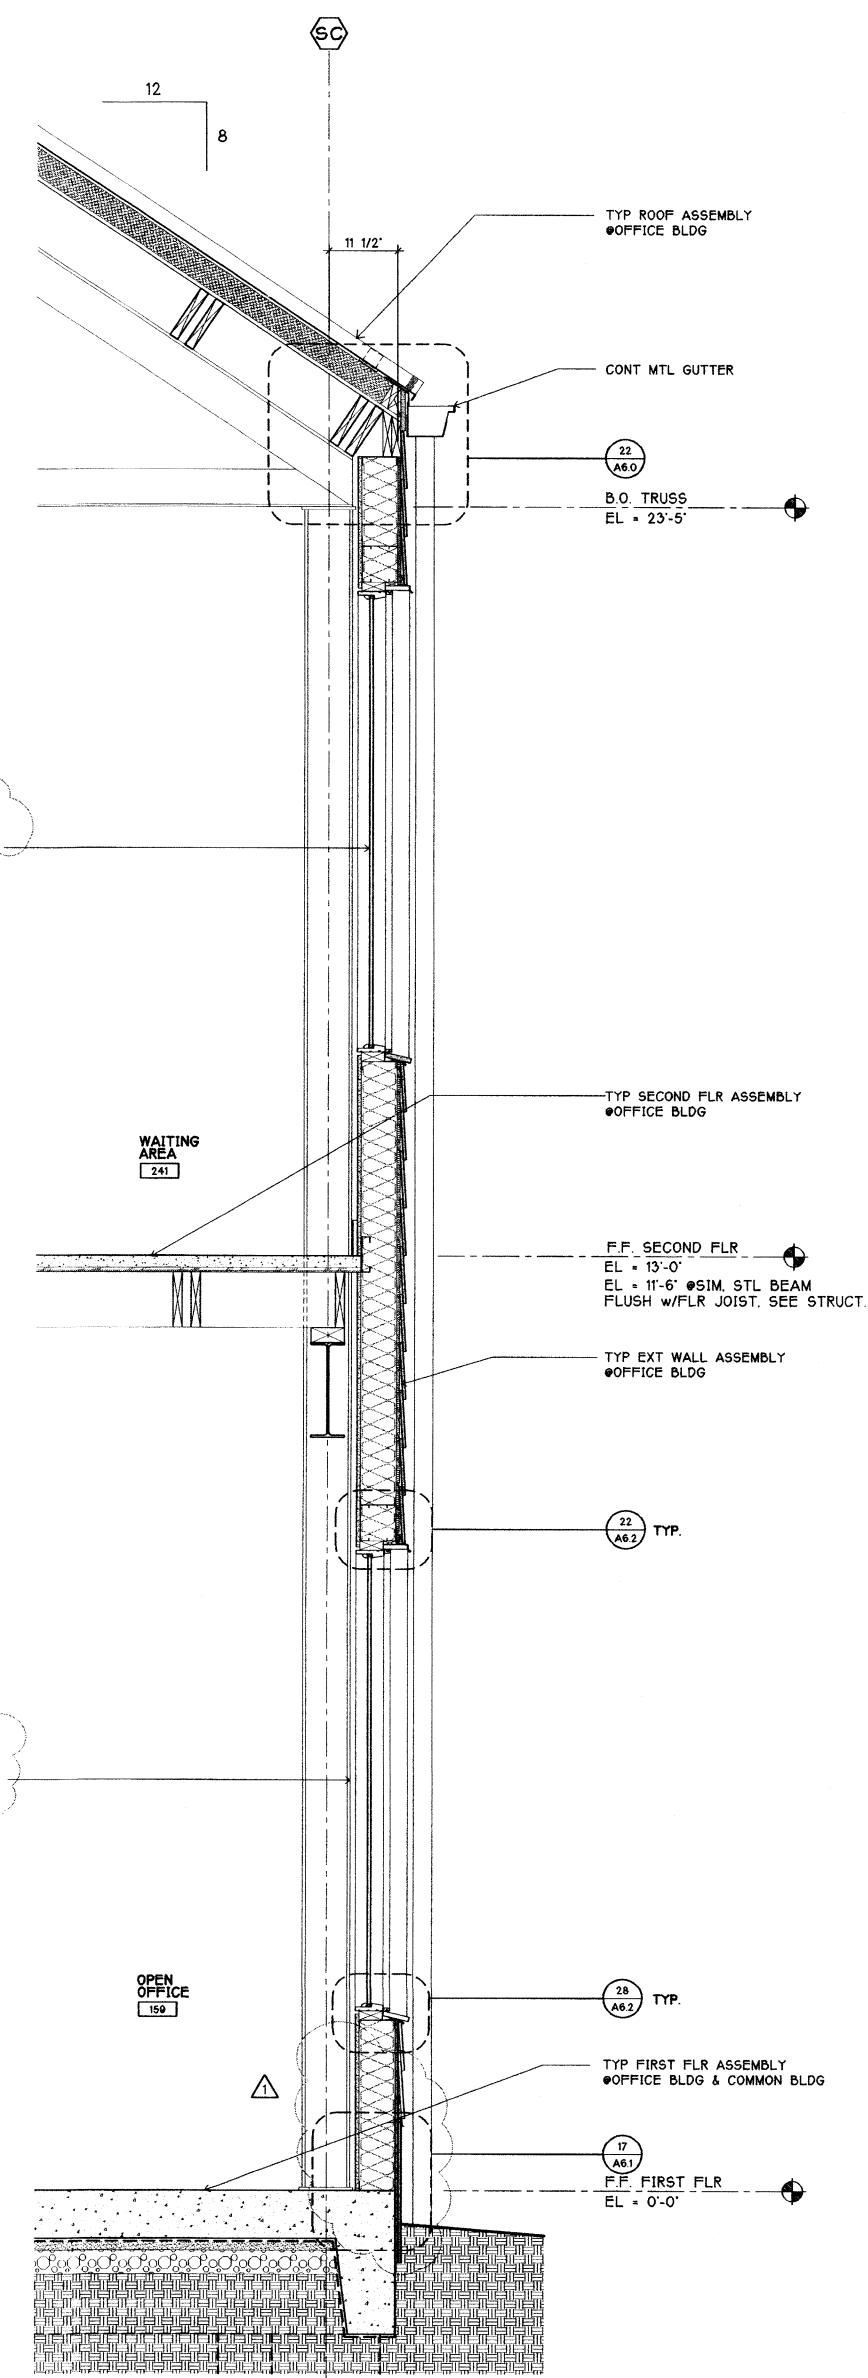

29 WALL SECTION @ OFFICE BLDG
 NOTE: SEE 25/A5.2 & 25/A5.3 FOR TYP NOTES & DIMS 3/4"=1'-0"