



25 TYP WALL SECTION THRU DOMER @OFFICE BLDG  
NOTE: SEE 25/A5.2 & 25/A5.3 FOR TYP NOTES & DIMS. 3/4" = 1'-0"

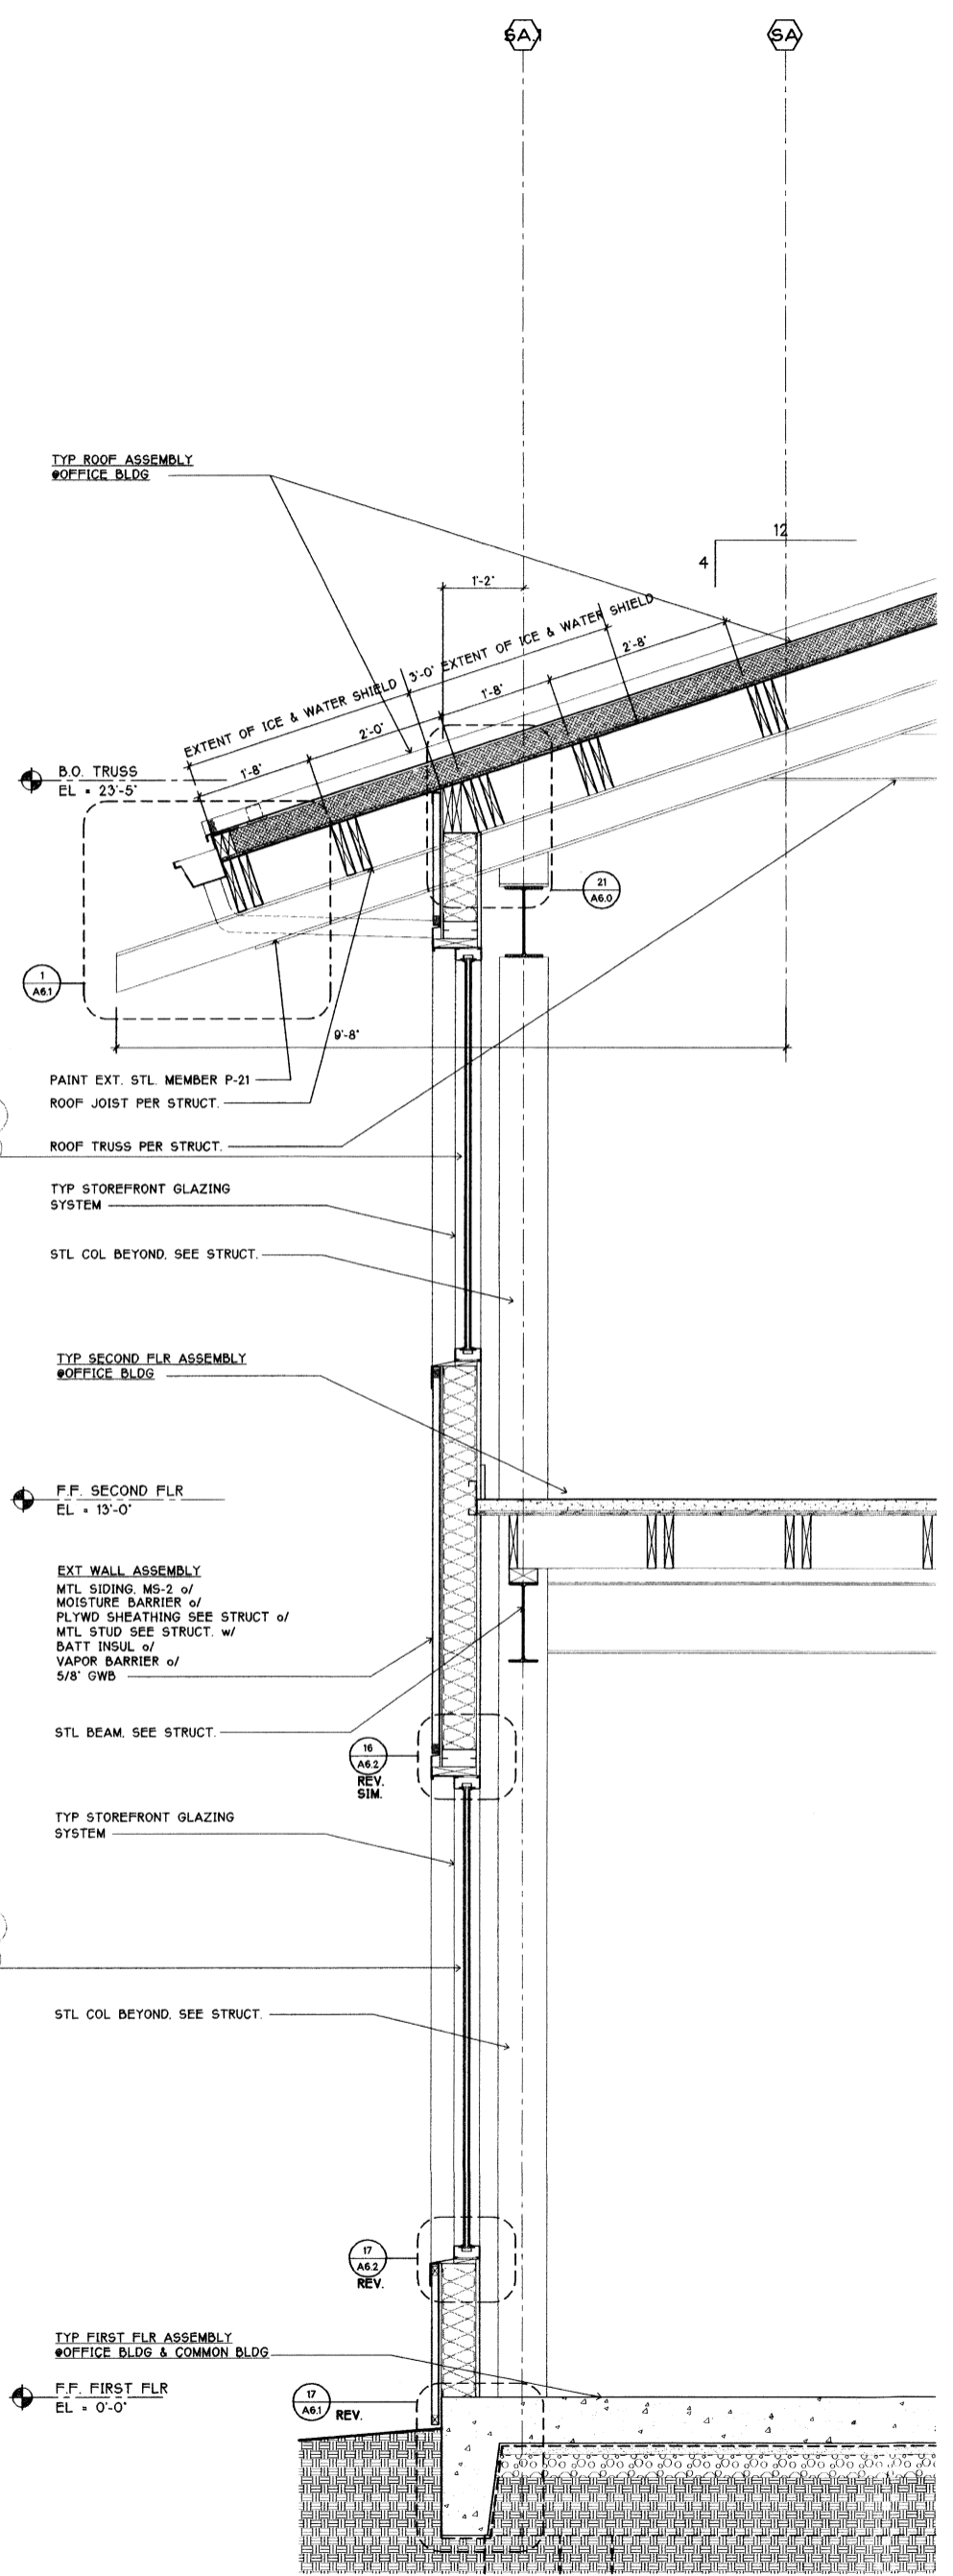

27 WALL SECTION @OFFICE BLDG  
NOTE: SEE 25/A5.2, A5.3, A5.4 FOR TYP NOTES & DIMS. 3/4" = 1'-0"

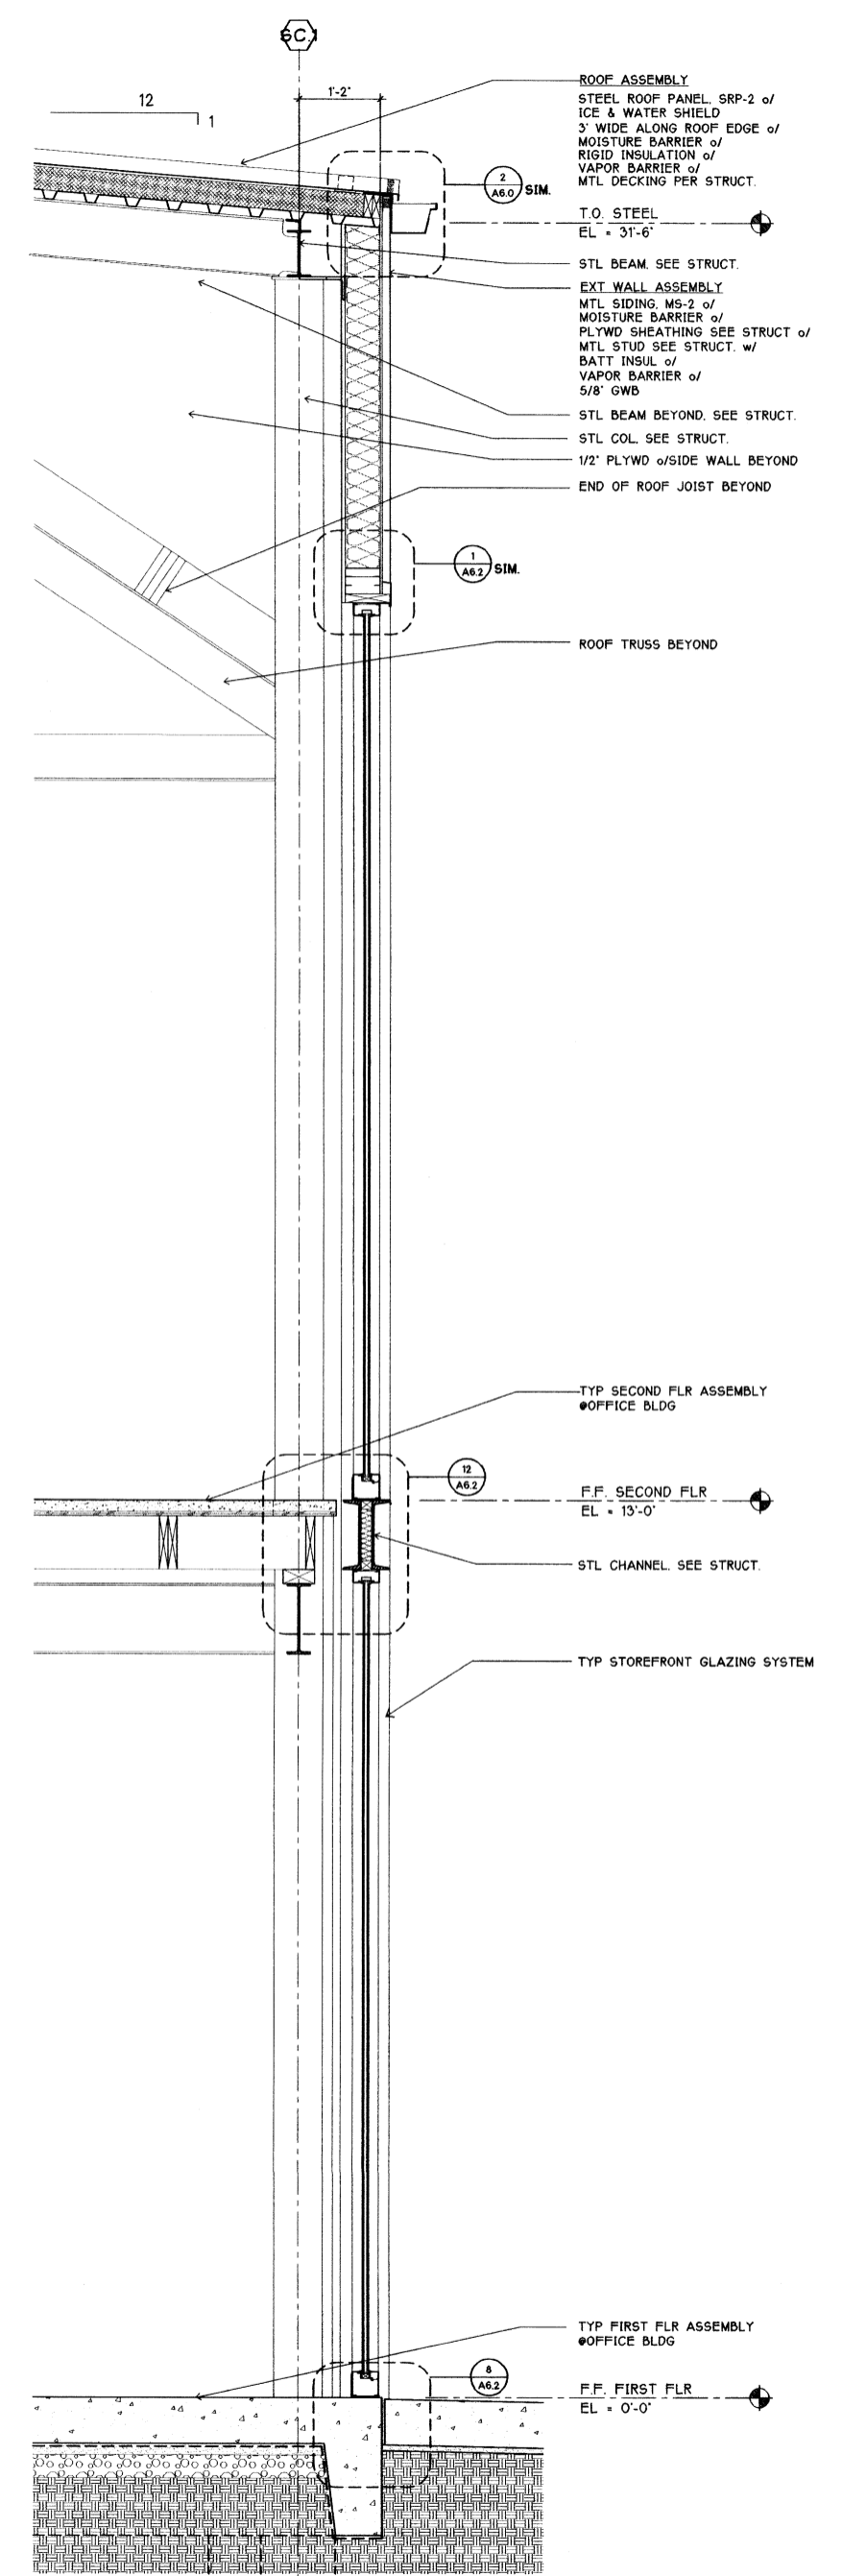

29 WALL SECTION @ WRIST OF OFFICE BLDG  
NOTE: SEE 25/A5.2, A5.3, A5.4 FOR TYP NOTES & DIMS. 3/4" = 1'-0"