



SUN HEALTHCARE SYSTEMS, INC.
CAMPUS: PHASE ONE
ANACORTES, WASHINGTON

SCALE 3/4"=1'-0"

DATE 5/18/99
 REVISION CON-STRU SET


BG
 PREPARED BY CHANCE
 RF
 PROJECT ARCHITECT
 DAS/DWG
 PROJECT ARCHITECT
 CH
 DESIGNER
 FB
 CHECKER

2029 REGISTERED ARCHITECT
 THOMAS D. EMERSON
 STATE OF WASHINGTON

WALL SECTIONS
 @OFFICE BLDG


98060.05
 PROJECT NO.
 MAY 18, 1999
 DATE
 E:\98060\CD\A5-5
 DRAWING FILE NAME

A5.5 CONSTRUCTION SET

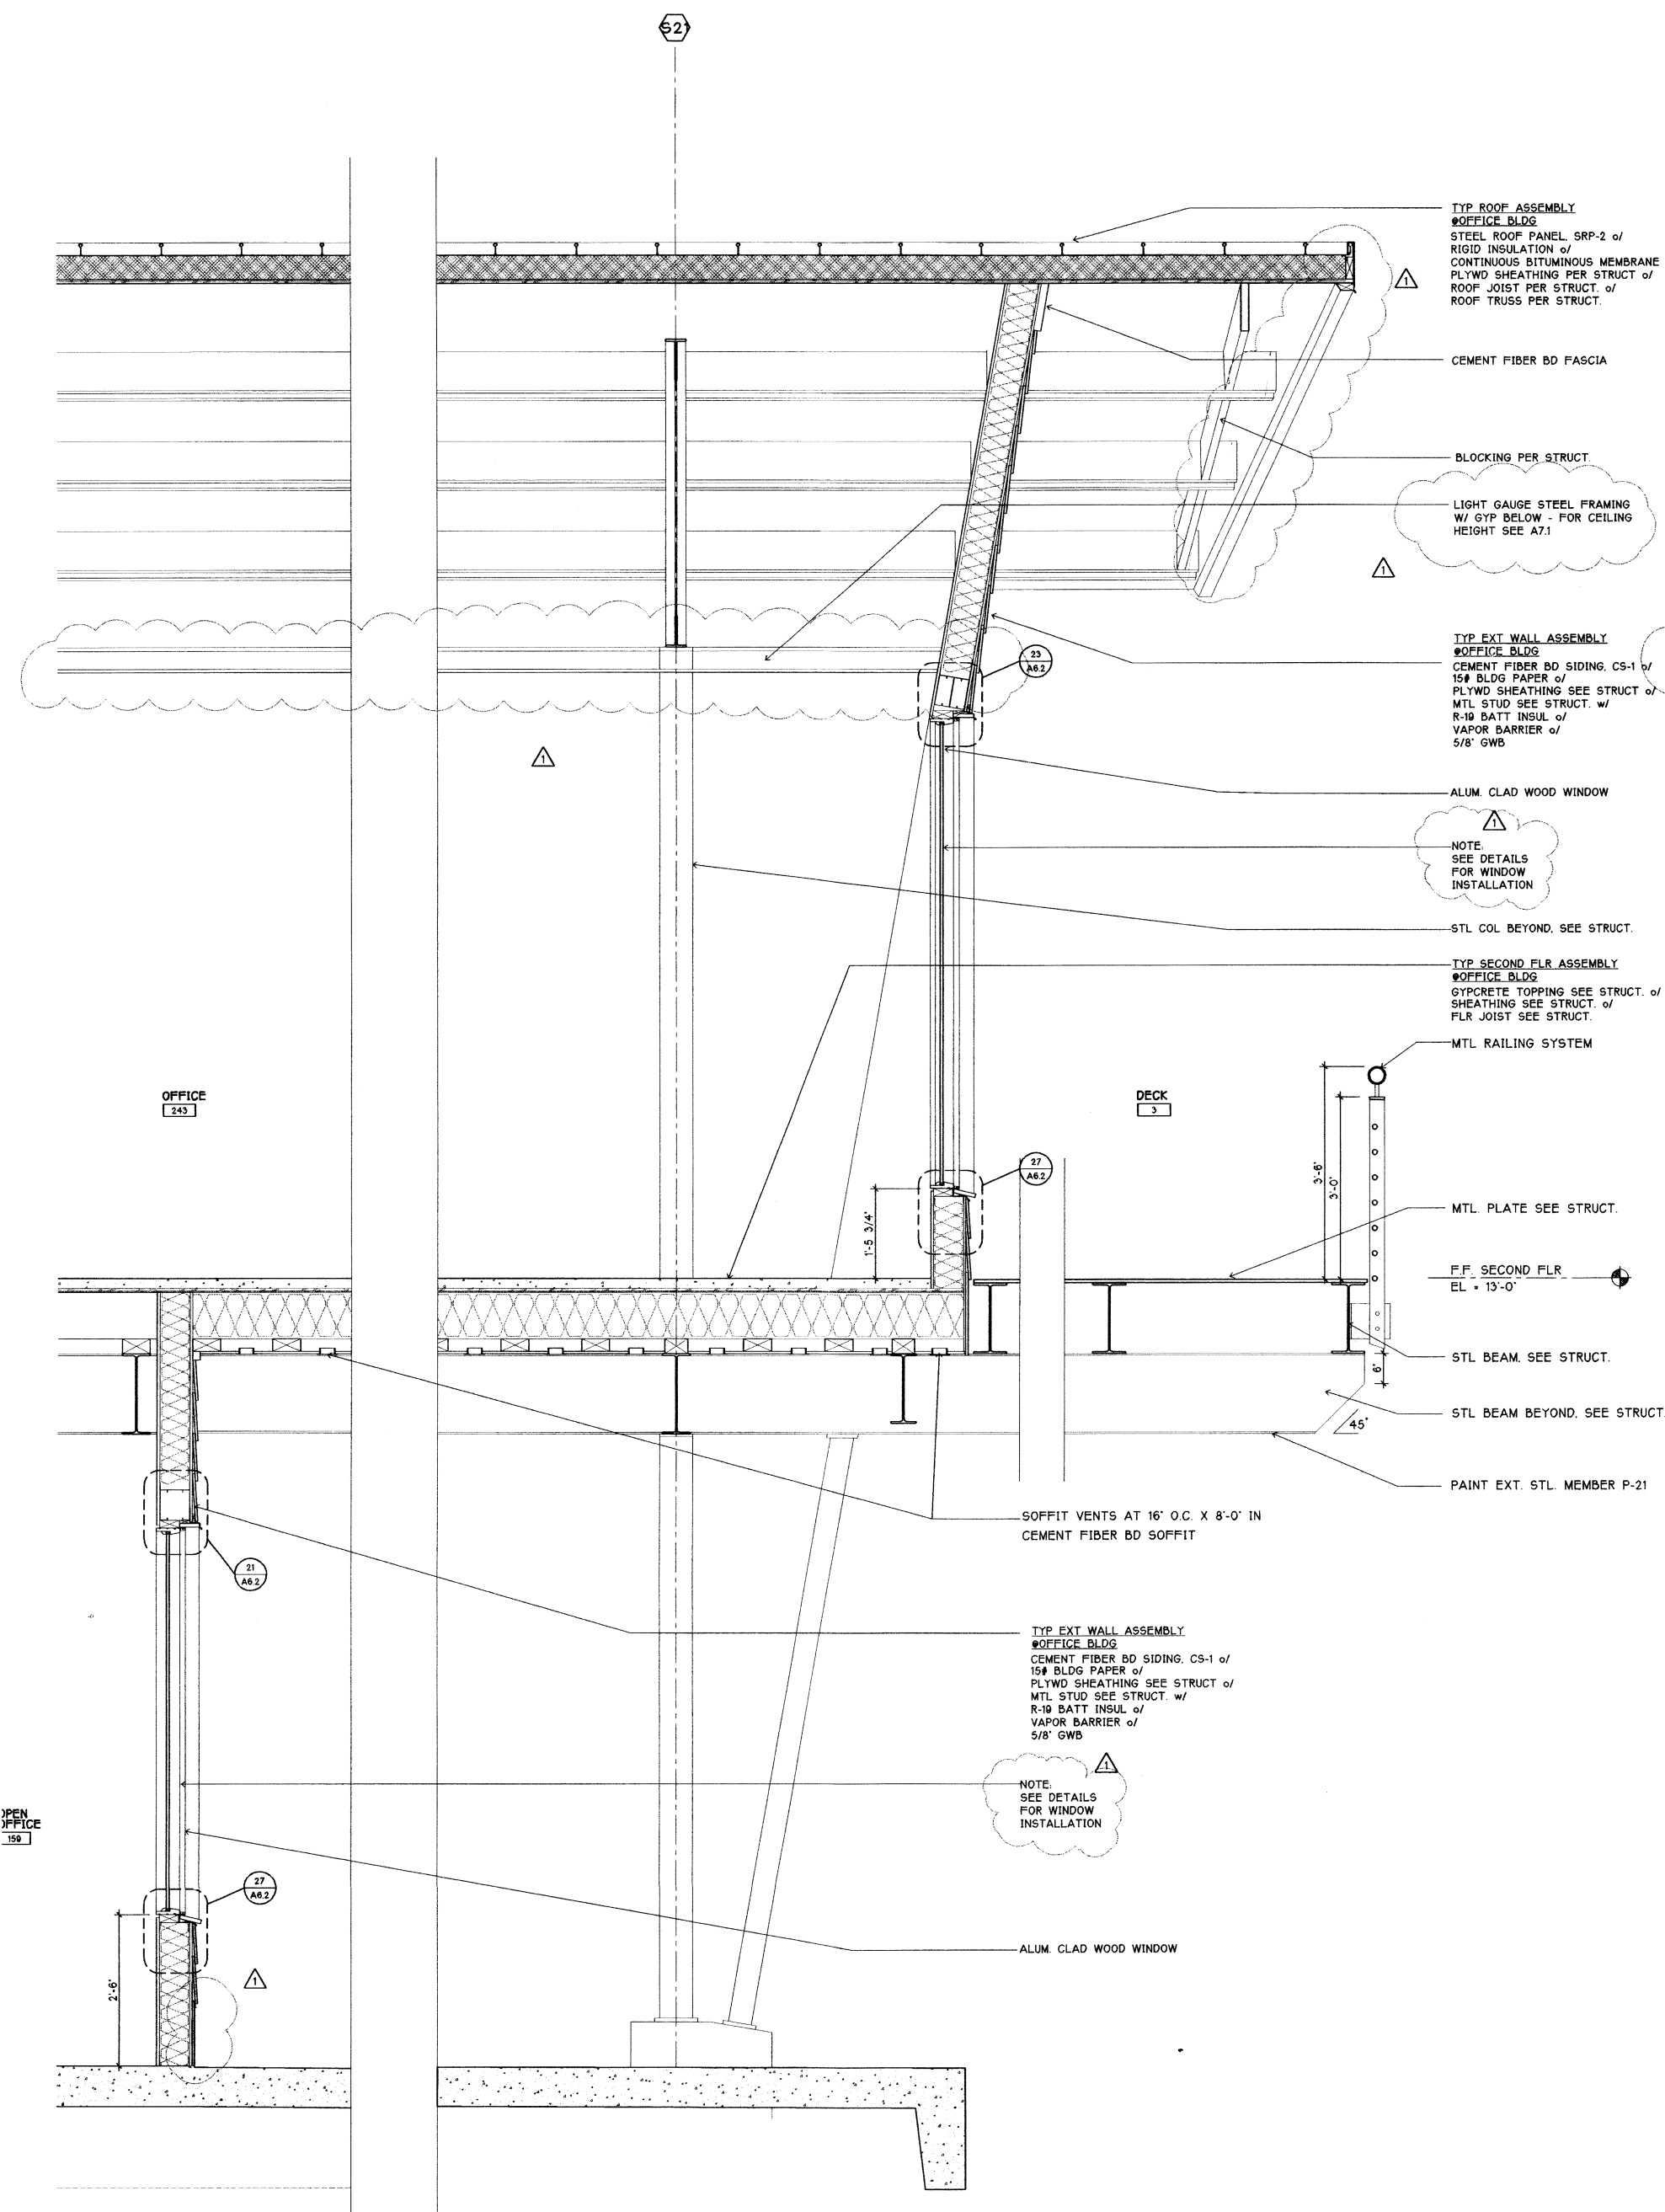

25 WALL SECTION @ EAST END OF OFFICE BLDG

3/4" = 1'-0"

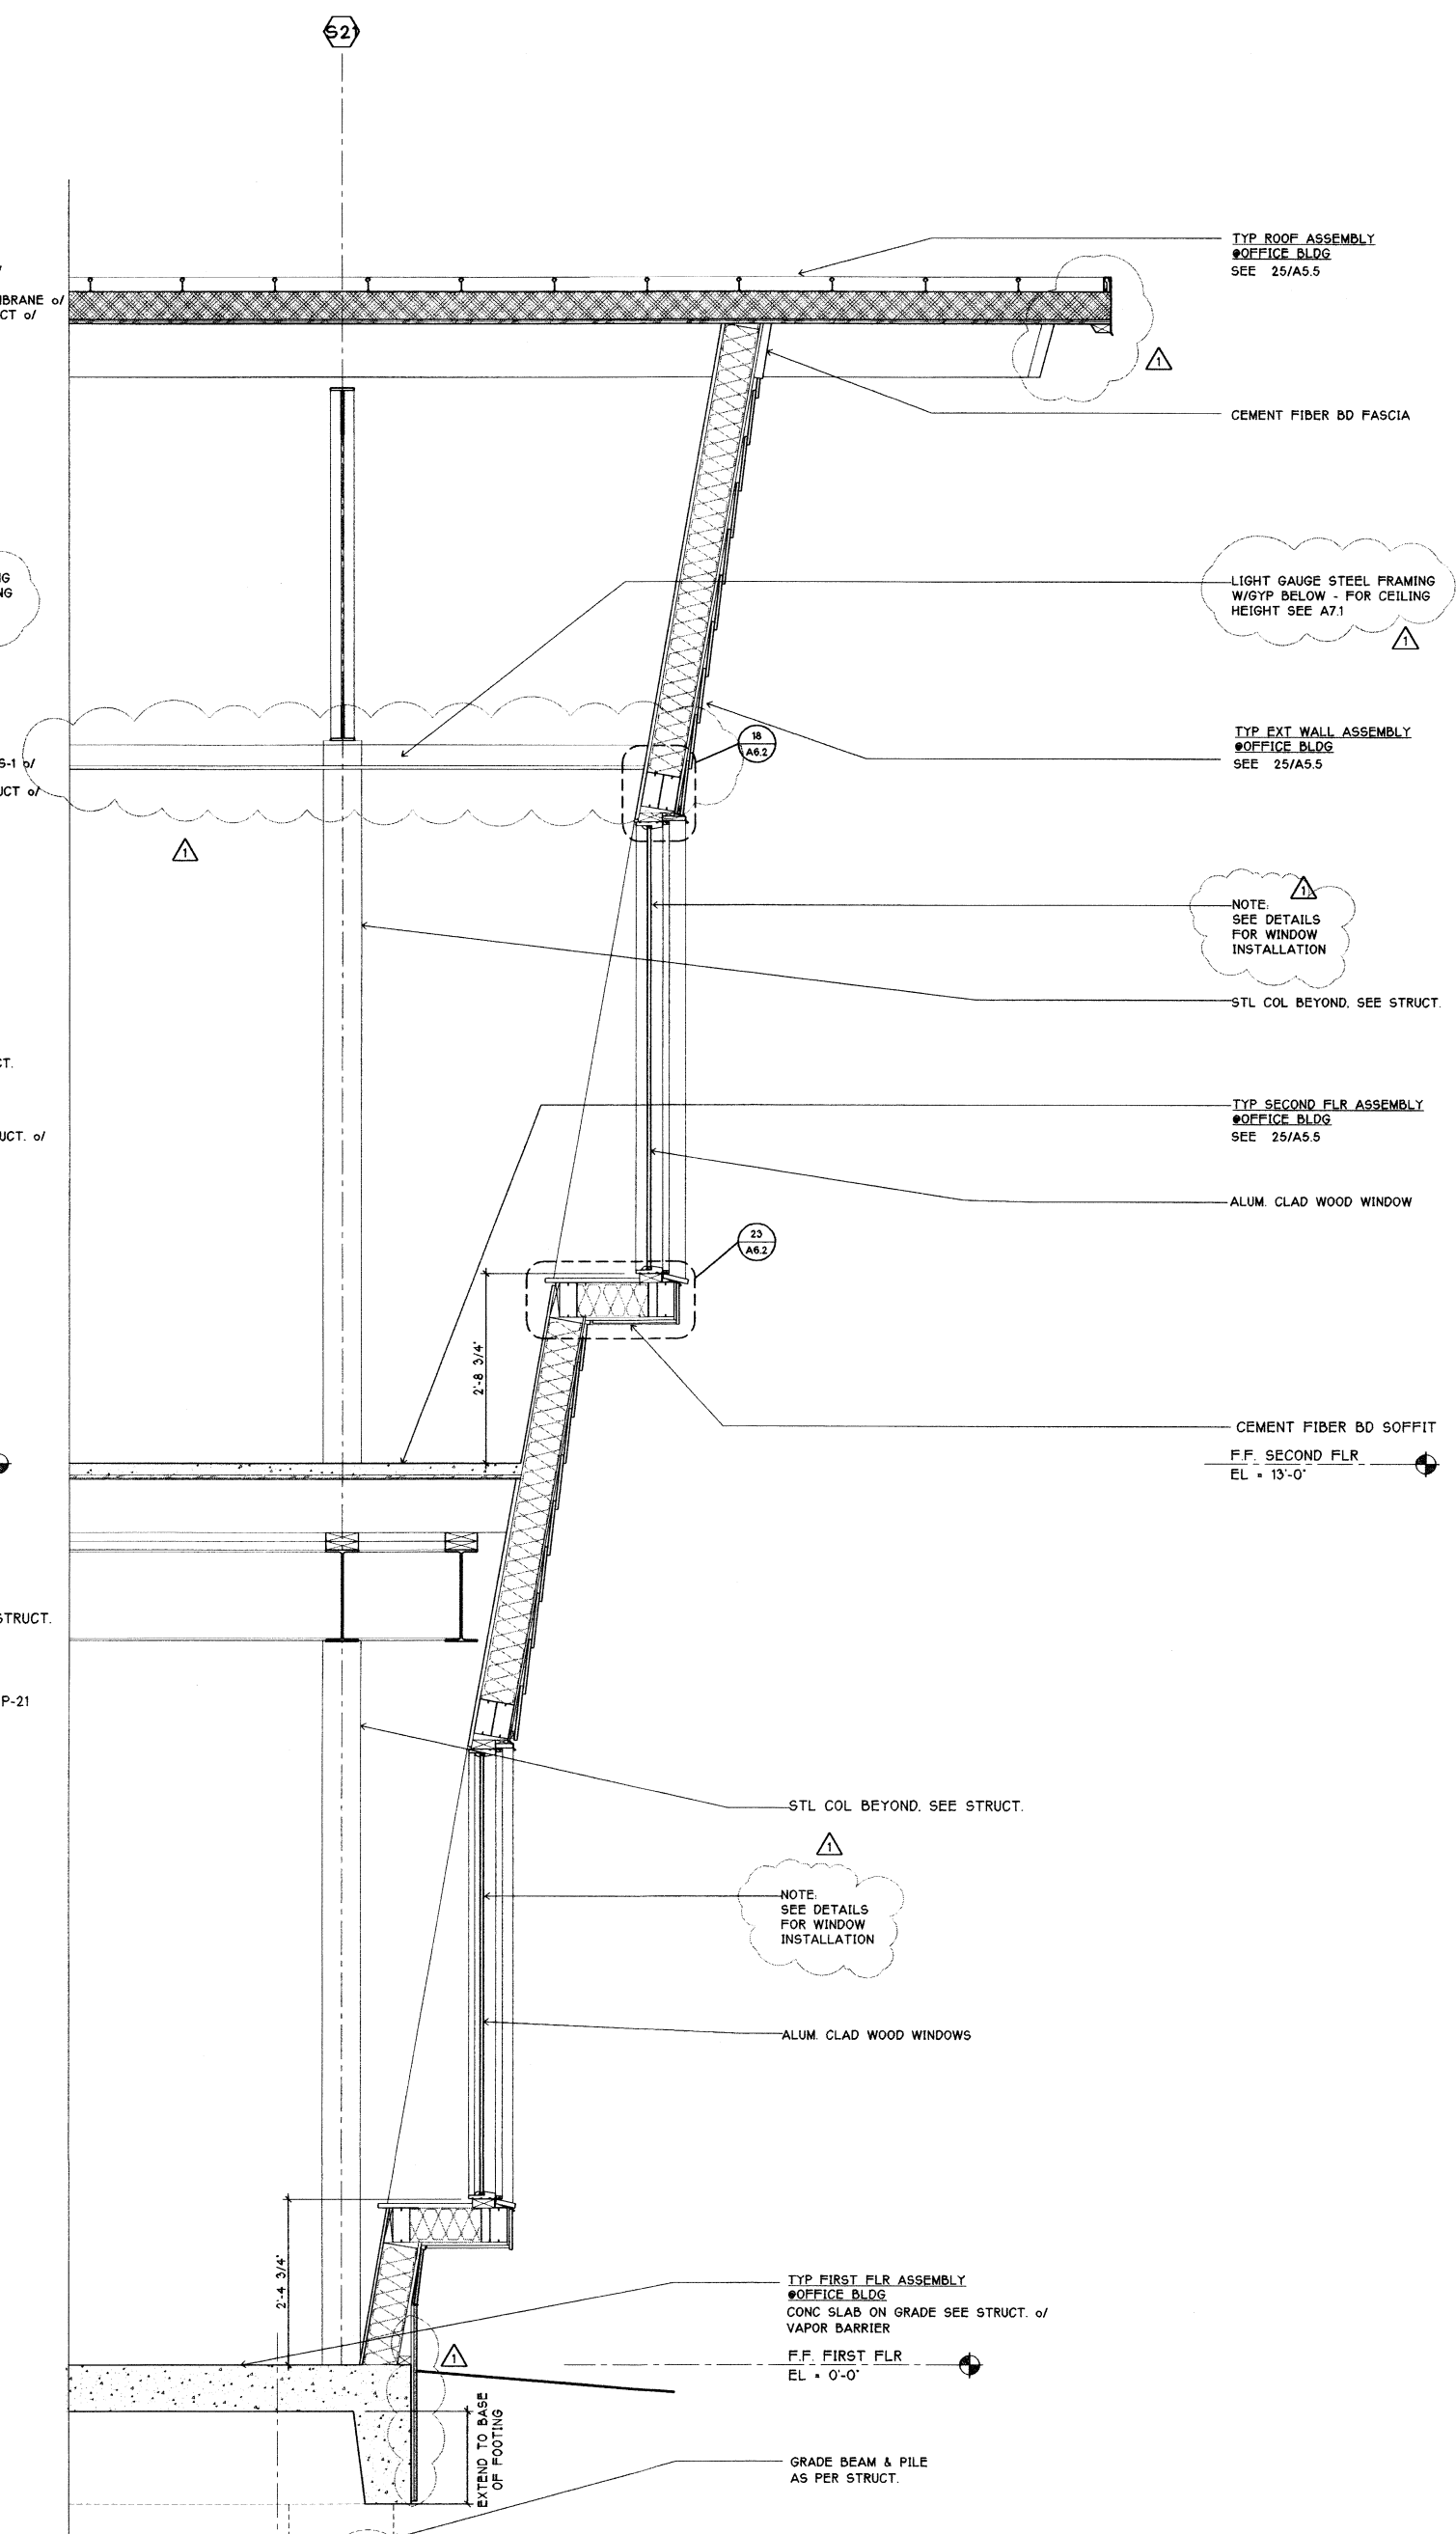

28 WALL SECTION @ EAST END OF OFFICE BLDG

3/4" = 1'-0"