

6 STORAGE MEZZ. PLAN
1/8" = 1'-0"

NOTE:
FURNITURE SHOWN FOR
REFERENCE ONLY. SEE mbi
SYSTEMS, INC. DRAWINGS FOR
ACCURATE WORKSTATION LAYOUT

26 SECOND FLOOR FINISH PLAN
1/8" = 1'-0"




SUN HEALTHCARE SYSTEMS, INC.
CAMPUS: PHASE ONE
ANACORTES, WASHINGTON



SCALE 1/8"=1'-0"
 2/22/99 PERMIT
 5/18/99 CONSTR. SET

BG
 RF
 DAS/DWG
 DAS/MS
 FB
 CBY

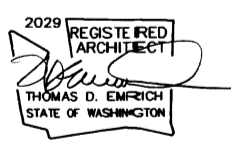

98060.05
 MAY 18, 1999
 E:\98060\DD\A9-1

A9.1 CONSTRUCTION SET