


Table with 15 columns: ROOM NAME, FLOOR, BASE, NORTH, SOUTH, EAST, WEST, CEILING, REMARKS. Includes sections for COMMONS BUILDING, DATA TOWER, SOUTH OFFICE BUILDING, and STAIRS.

FINISH SCHEDULE LEGEND & PRODUCT SPECIFICATION table listing items (CPT, RB, PL, S, C, F), descriptions, and remarks.

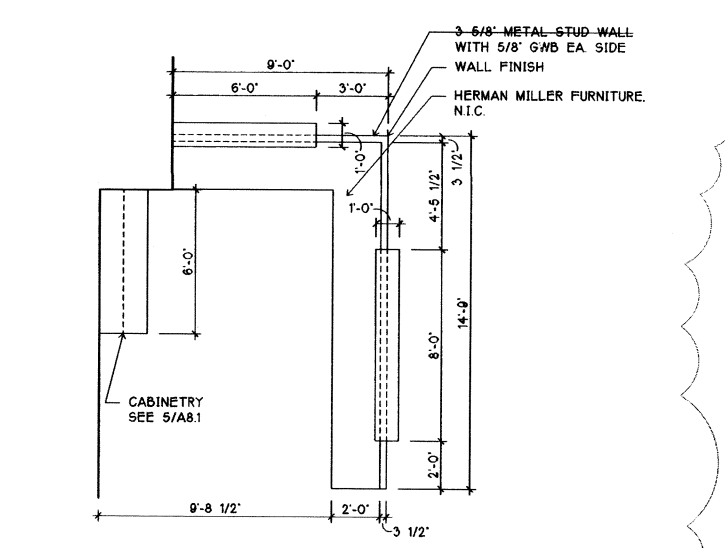

30 RECEPTION DESK 1/4\"/>

FINISH SCHEDULE

88060.05 MAY 18, 1999 E:\98060\CD\IA9-3.DWG