
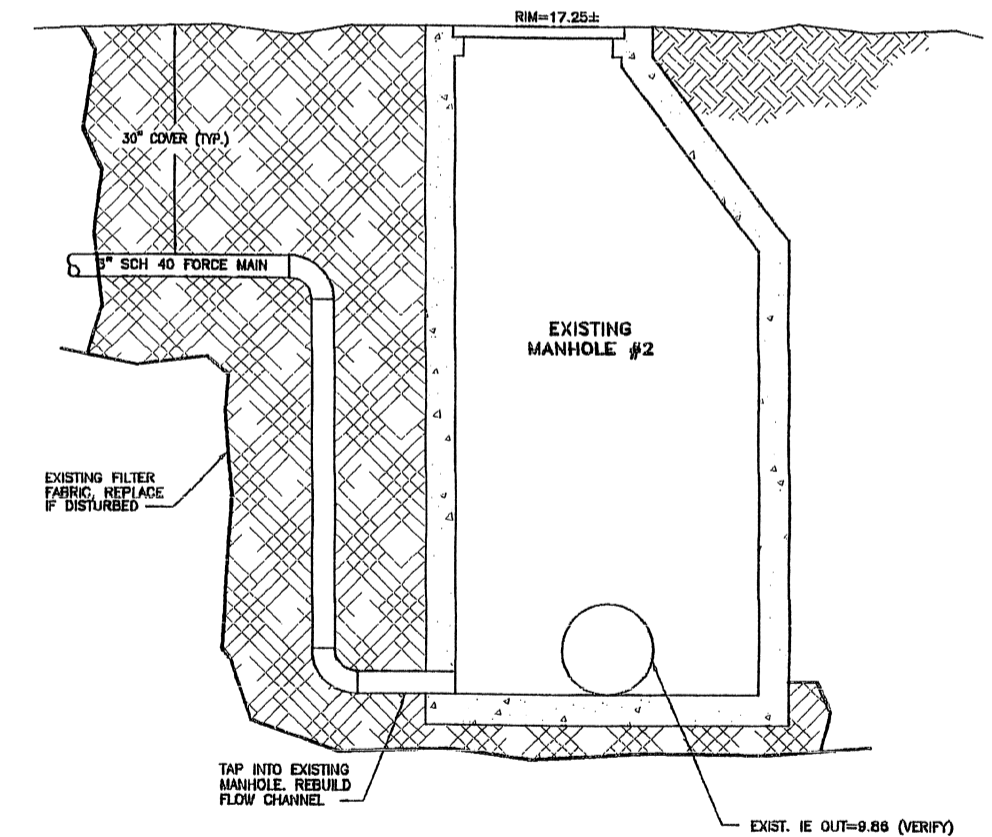
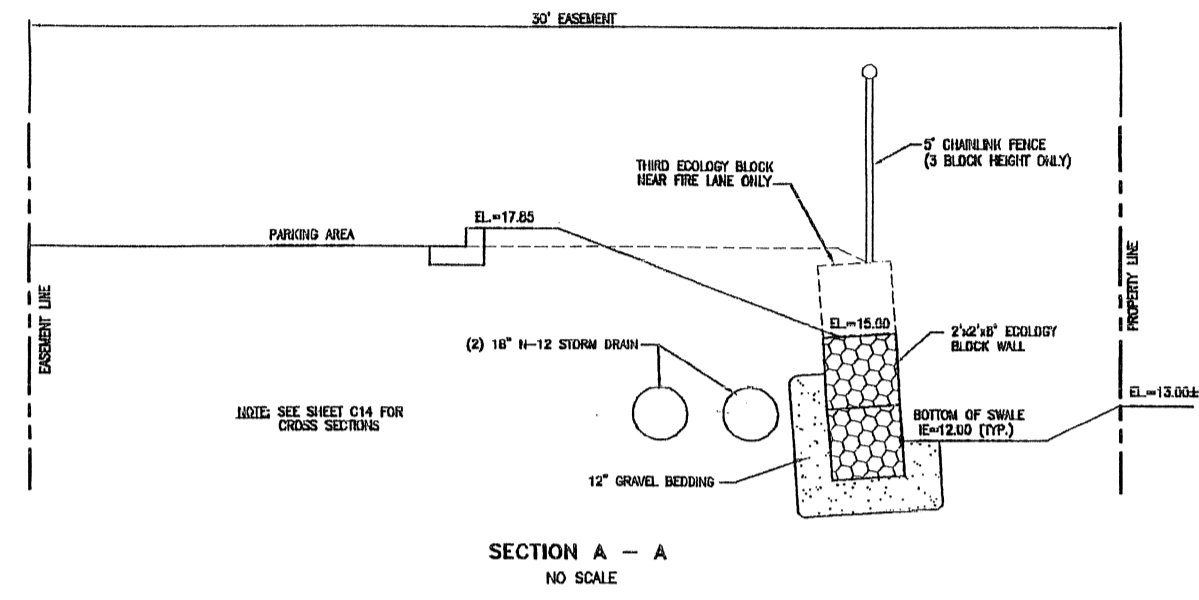
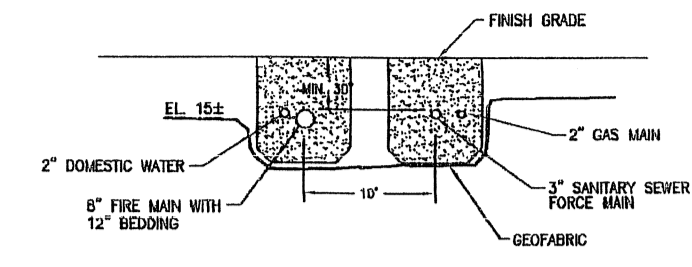


CAP SANTE BOAT MARINA

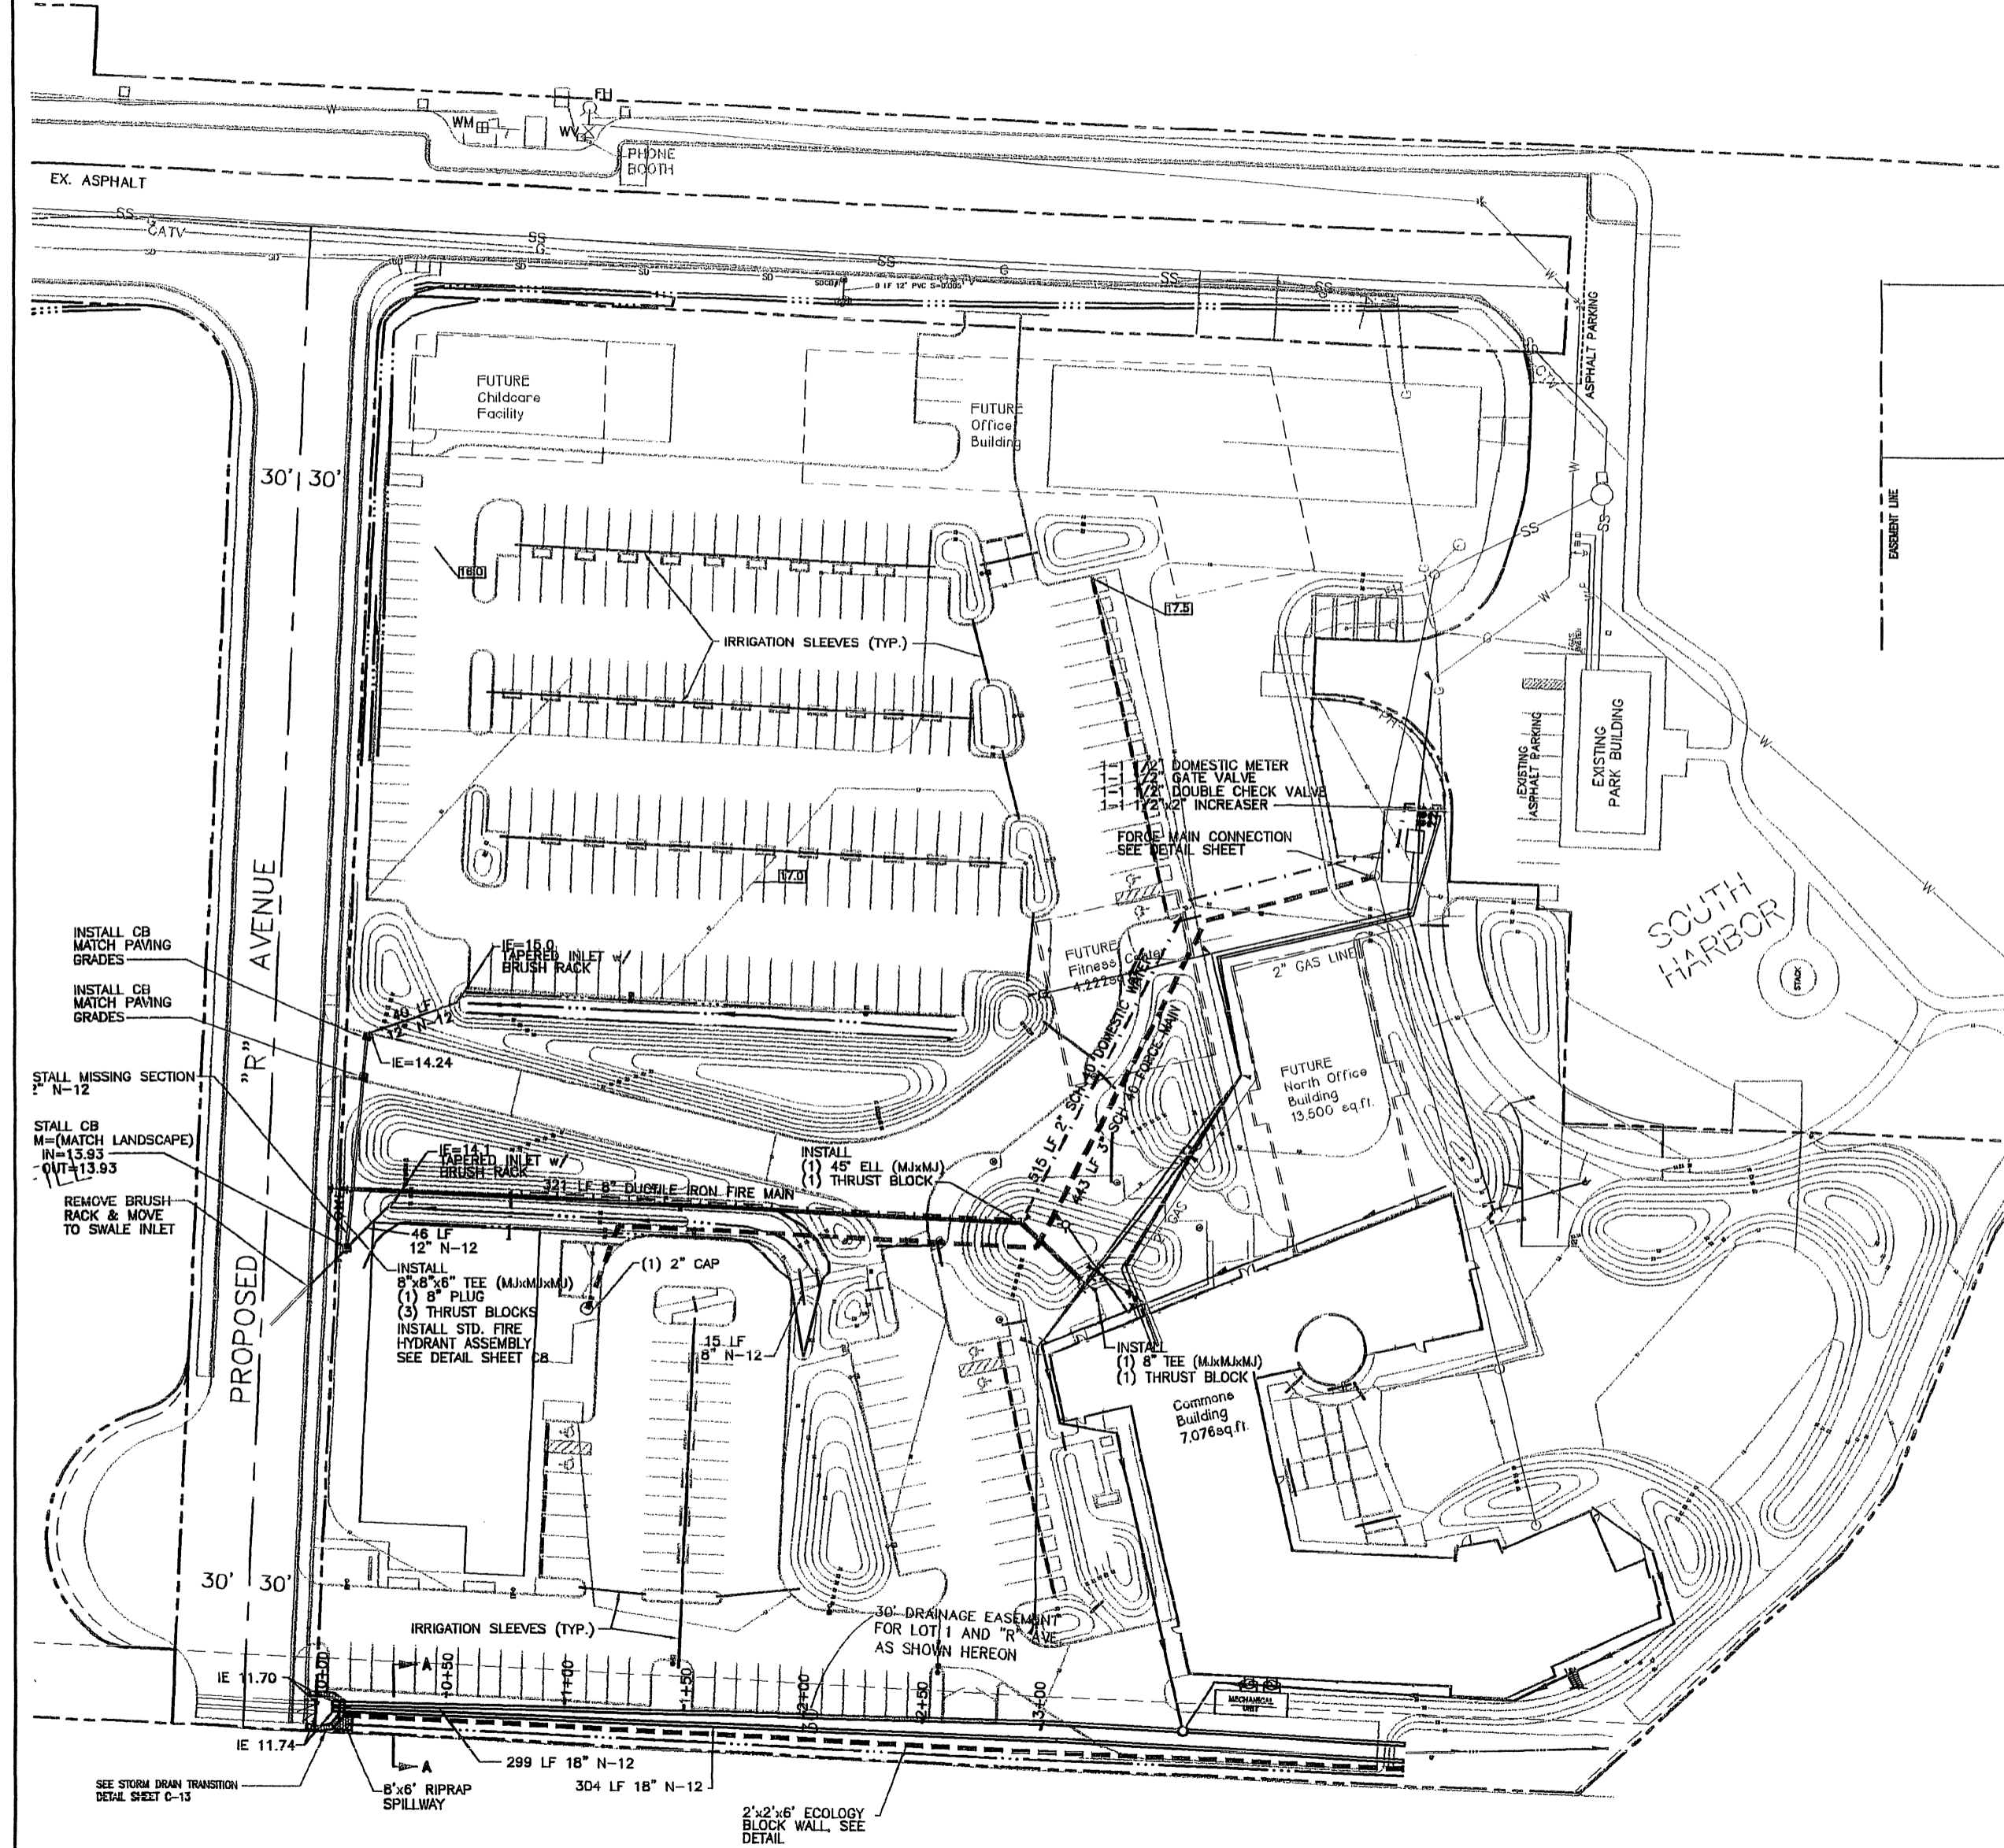

APPROVED FOR CONSTRUCTION
 CITY ENGINEER DATE
 APPROVAL EXPIRES ONE YEAR FROM DATE SHOWN

CALL 48 HOURS
 BEFORE YOU DIG
 1-800-424-5555

DESIGNED	US	DATE	12/05/99
DRAWN	US	BY	
CHECKED	US		
<p>SCHEMMER ENGINEERING INC. 1004 COMMERCIAL AVENUE, SUITE 152 ANACORTES, WA 98221-4183 (360) 293-9006</p>			
<p>SHS - HEALTH FACILITY</p>			
<p>SITE UTILITIES</p>			
JOB NO.	08-073		
SHEET	C12		
<p>12 OF 14</p>			