

SCALE: 1" = 20'

SEE SHEETS L-1.1 & 1.2 FOR CENTERLINE HORIZONTAL CONTROL & HARDSCAPE

SEE STOP SIGN & STOP BAR DETAILS SHEET C-11

FUTURE Fitness Center 4,222 sq. ft.



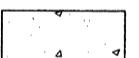
FUTURE North Office Building 13,500 sq. ft.

YARD DRAINS SEE SHEETS L-1.2, L-2.2

Commons Building 7,076 sq. ft.

TREE PLANTER SEE SHEET L-1.1

NOTE:  
FOR CROSS SECTION DETAILS, SEE SHEET C10.

- LEGEND:
-  HEAVY ASPHALT SEE DETAIL SHEET C11
  -  REINFORCED TURF
  -  CONCRETE

DESIGNED BY	SK	ML	BY
DRAWN BY	SK	ML	BY
CHECKED BY	SK	ML	BY
REVISIONS	DATE	BY	APP
7/6/99	5/1/98		
REVISED PER CITY REVIEW			
REVISED PER ARCHITECT REVIEW			



**SUN SYSTEMS, INC.**  
 1004 COMMERCIAL AVENUE, SUITE 152  
 ANACORTES, WA 98221-4183 (360) 293-1960

**SUN SYSTEMS, INC.**  
**PAVING-PARKING**

JOB NO.	98-02
SHEET	C9
	9 OF 11