


Mithun Partners, Inc.

Construction Set

May 18, 1999



Tex's
SHS office
Set

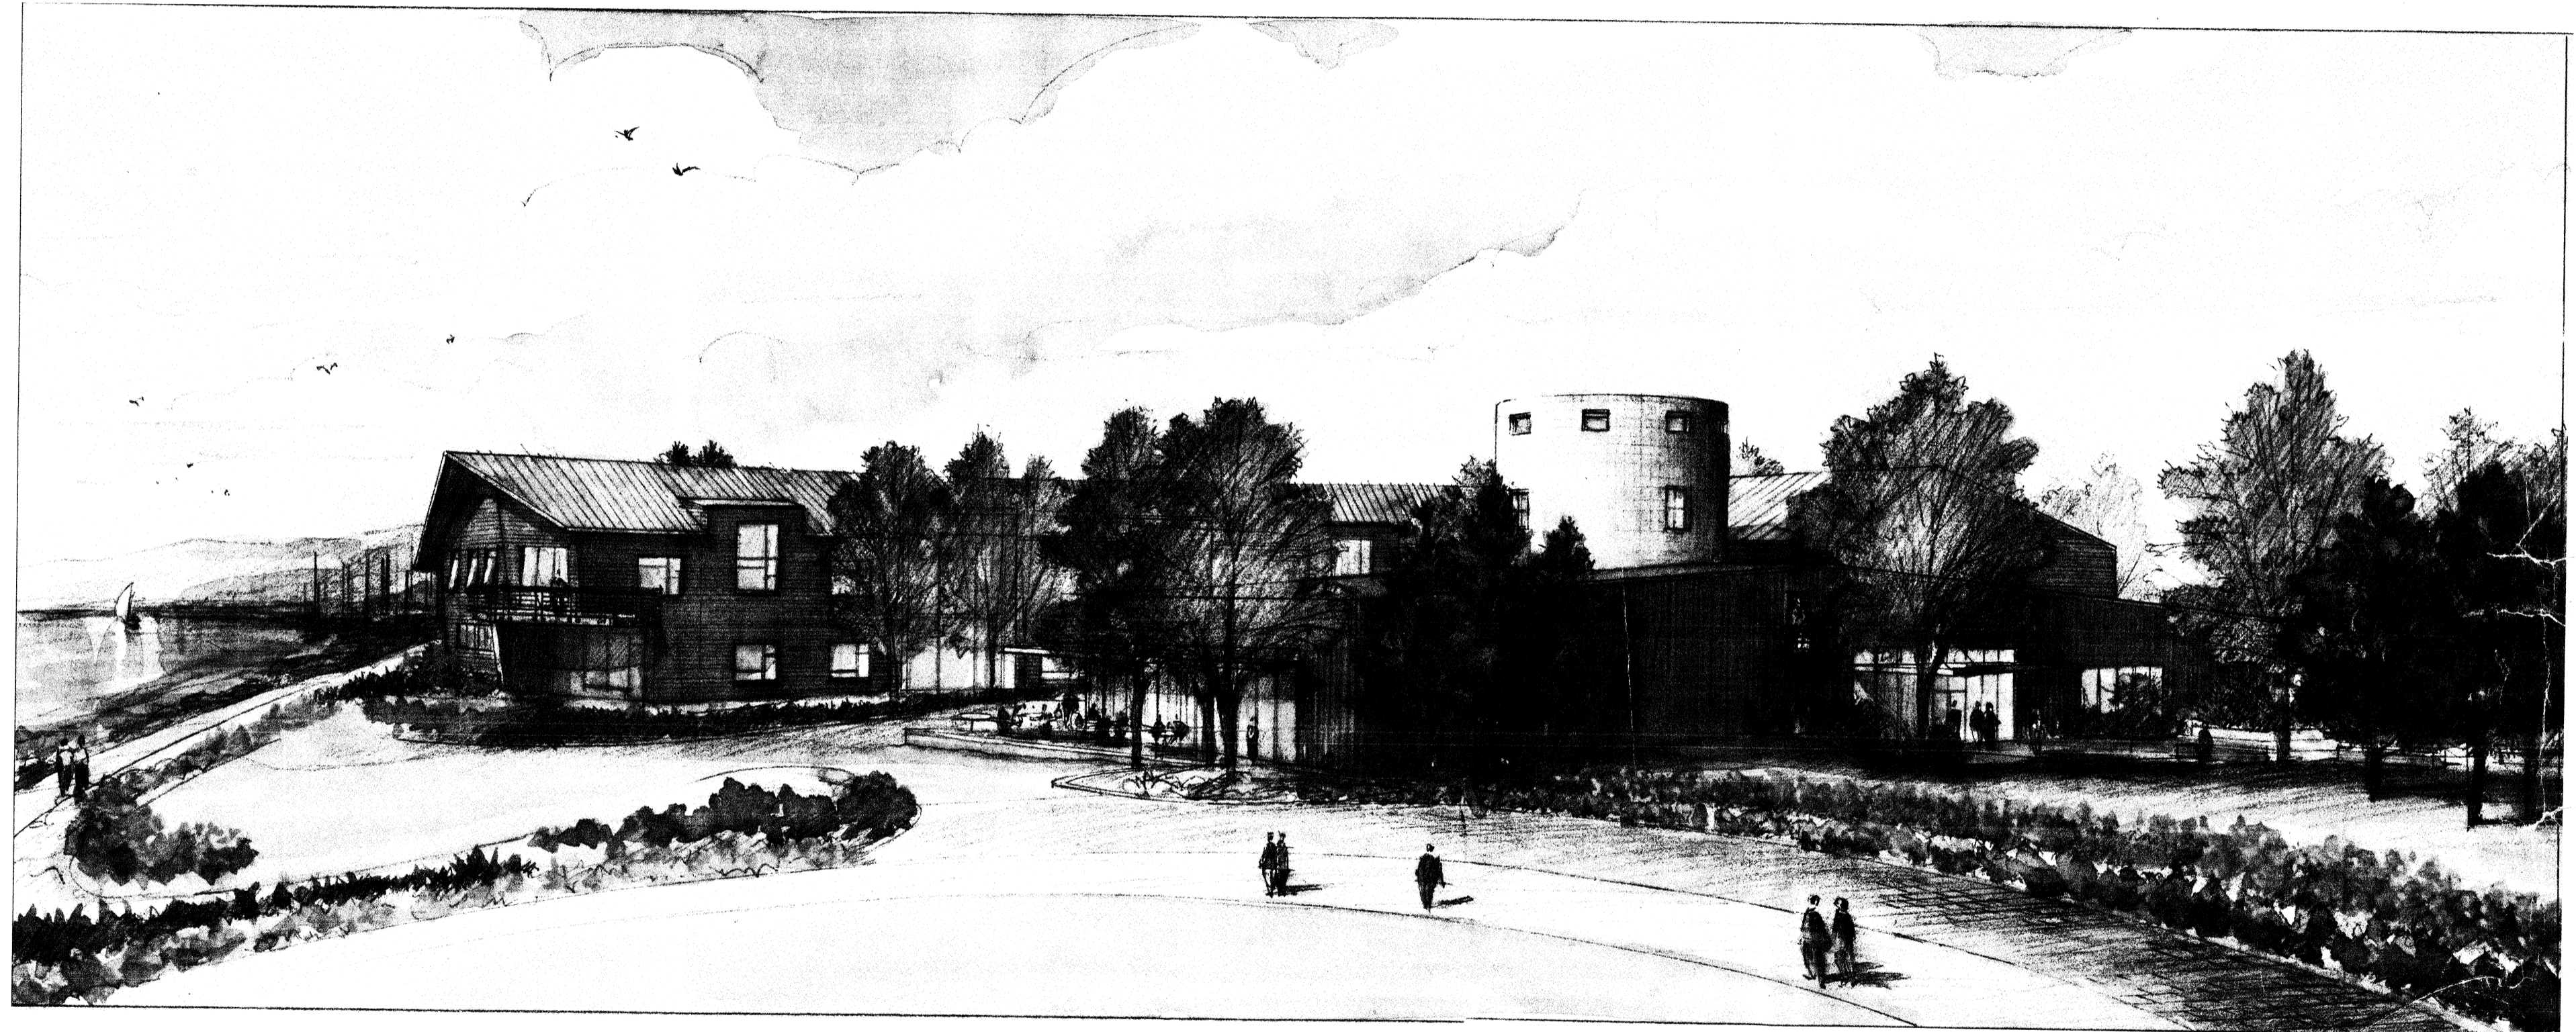

Sun Healthcare Systems, Inc.

Campus: Phase One

Anacortes, Washington

