

**FLAGNOTES**

EXTEND CAMERA POWER & CO-AX CONDUCTORS UP POLE TO CAMERA LOCATION. COORDINATE WITH OWNER FOR CAMERA MOUNTING INFORMATION. SEE SHEET #18 FOR CAMERA CABLING SPECIFICATIONS. CONTRACTOR TO COORDINATE WITH PUGET POWER FOR POLE MOUNTED CAMERA AND SIGNAL CABLE INSTALLATION ON PUGET POWER PROVIDED POLES.


**GENERAL NOTES**

- SEE LIGHTING PLANS AND FIXTURE SCHEDULE FOR FIXTURE SYMBOLS AND TYPES. REFER TO SPECIFICATIONS SECTION 16110 FOR DUCT TYPE AND CROSSING REQUIREMENTS.
- CONTRACTOR SHALL INSTALL MANHOLES AND DUCT BANKS AT EXACT LOCATIONS AS DIRECTED BY CIVIL ENGINEER.
- ALL STEEL CONDUIT INSTALLED UNDERGROUND, INCLUDING ELBOWS TO SURFACE, SHALL BE PVC COATED OR WRAPPED PER SPECIFICATIONS.

SCALE: 1" = 20'

5/18/99 CONST. SET

DOUG BORS  
BILL VAN VLACK, PE  
ED SANTOS  
BVV

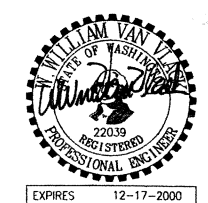

**ELECTRICAL AND COMMUNICATIONS SITE PLAN**

98060  
DATE PROJECT: FEBRUARY 9, 1999  
SHEET NUMBER: 7651  
SCALE: 1" = 20'

**E1.0**

CONSTRUCTION SET