

SUN HEALTHCARE SYSTEMS, INC.
CAMPUS: PHASE ONE
ANACORTES, WASHINGTON


NO.	DATE	REVISION

DR
 DESIGNER IN CHARGE

PROJECT MANAGER

PROJECT ARCHITECT

DATE
 DR/AS
 DATE

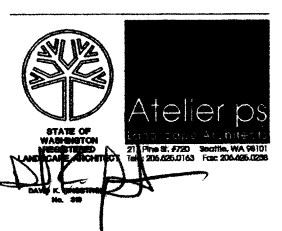

ENLARGED GRADING
 PLAN

98060.00
 PROJECT NO.
 MAY 18, 1999
 DATE

CONTRACT FILE NO.

L2.2
 SHEET NO.
 CONSTRUCTION SET