




① SECTION A-AA  
 SCALE: 1/4" = 1'-0"

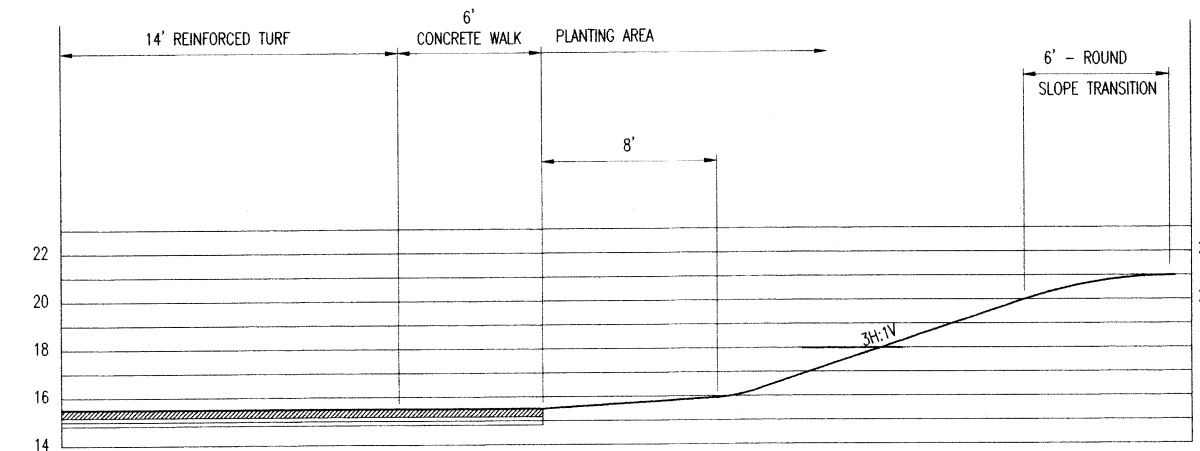

② SECTION B-BB  
 SCALE: 1/4" = 1'-0"

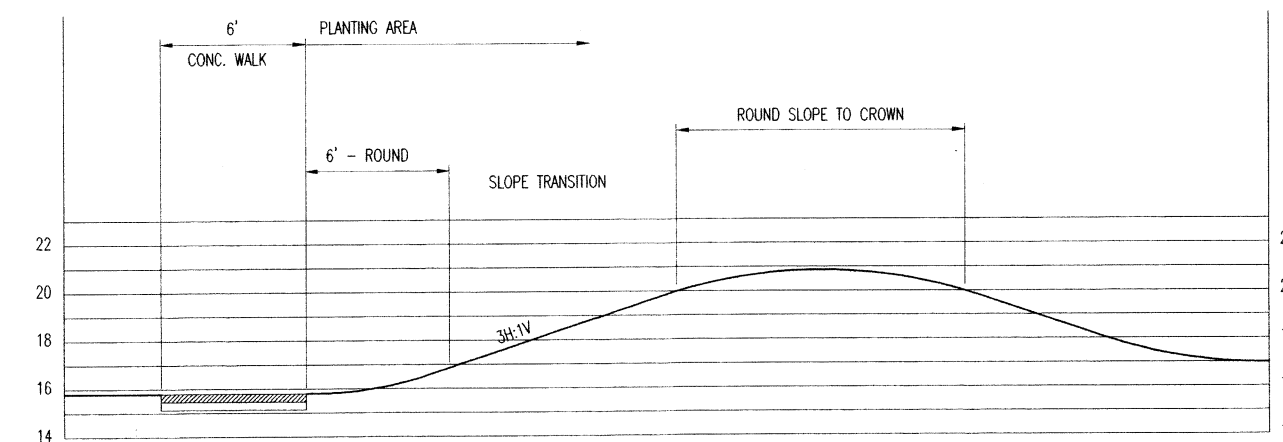

③ SECTION C-CC  
 SCALE: 1/4" = 1'-0"

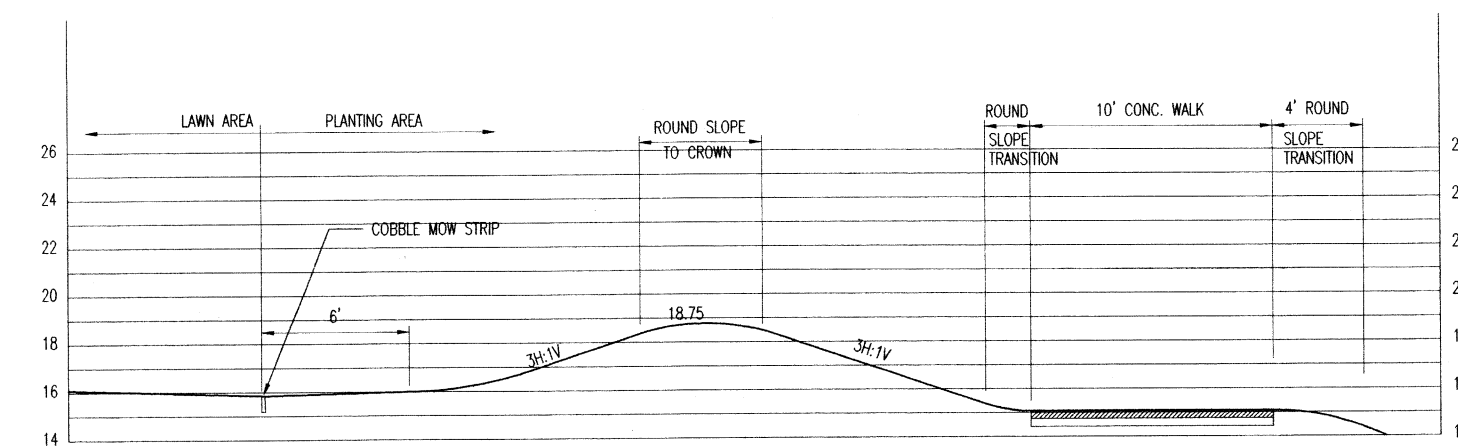

④ SECTION D-DD  
 SCALE: 1/4" = 1'-0"

NO.	DATE	REVISION

DR  
 PREPARED BY CHANGE  
 PROJECT NUMBER  
 PROJECT ADDRESS  
 DRAWN  
 DR/AS  
 CHECK

