




1 REINFORCED TURF POROUS PAVEMENT  
SCALE: 1" = 1'-0"  
TYP. SECTION

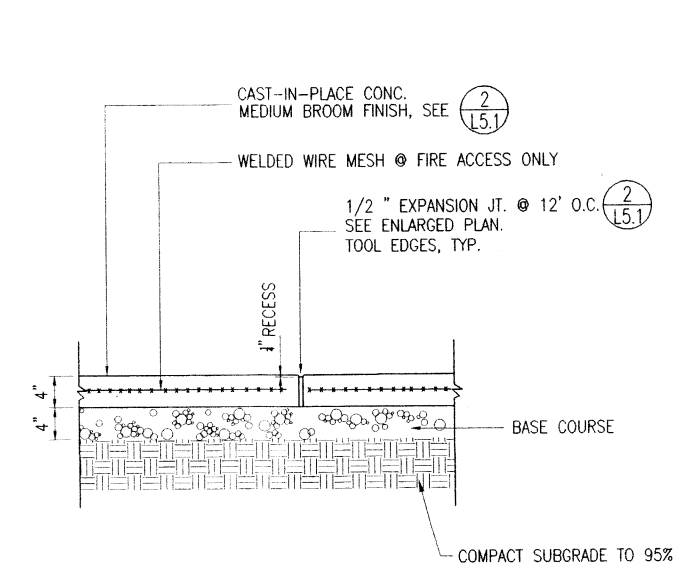


2 CONCRETE ESPLANADE  
SCALE: 1" = 1'-0"  
LONGITUDINAL SECTION

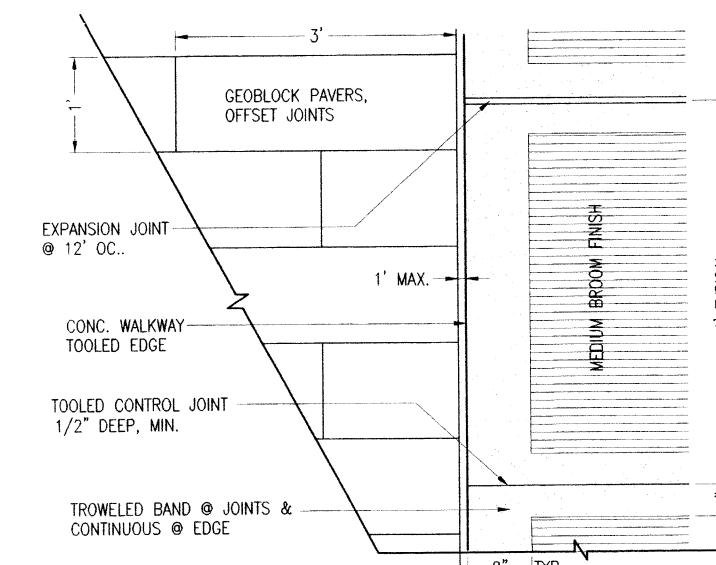


3 CONC. WALKWAY/REINFORCED TURF  
SCALE: 1" = 1'-0"  
PARTIAL PLAN

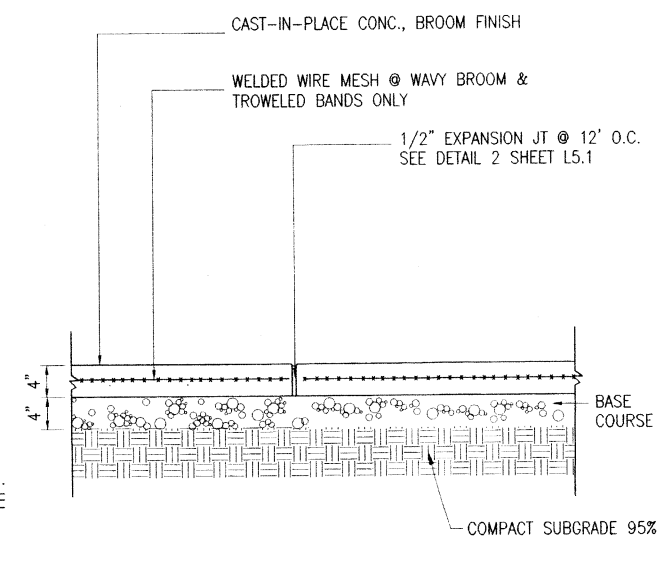


4 CONCRETE WALKWAY  
SCALE: 1" = 1'-0"  
LONGITUDINAL SECTION

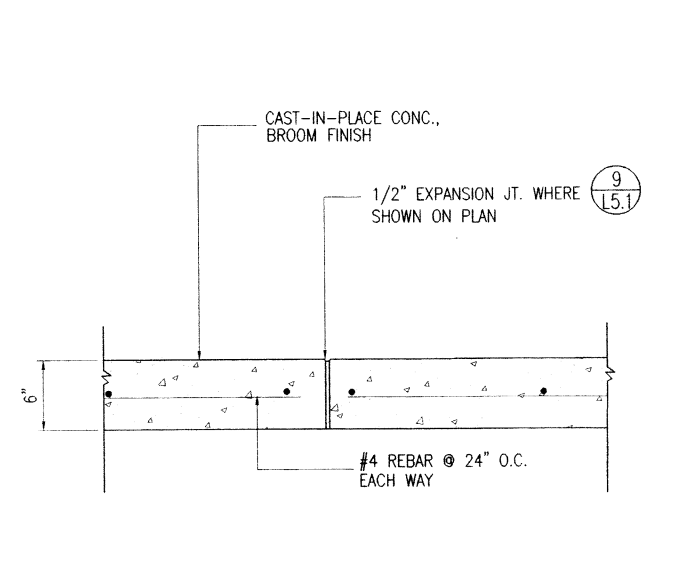


5 REINFORCED CONCRETE  
SCALE: 1" = 1'-0"  
SECTION

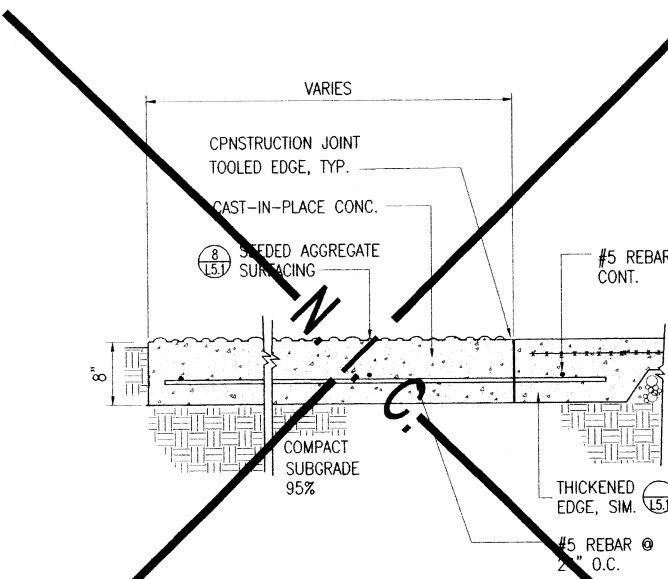


6 COBBLE PAVING  
SCALE: 1" = 1'-0"  
TYP. SECTION

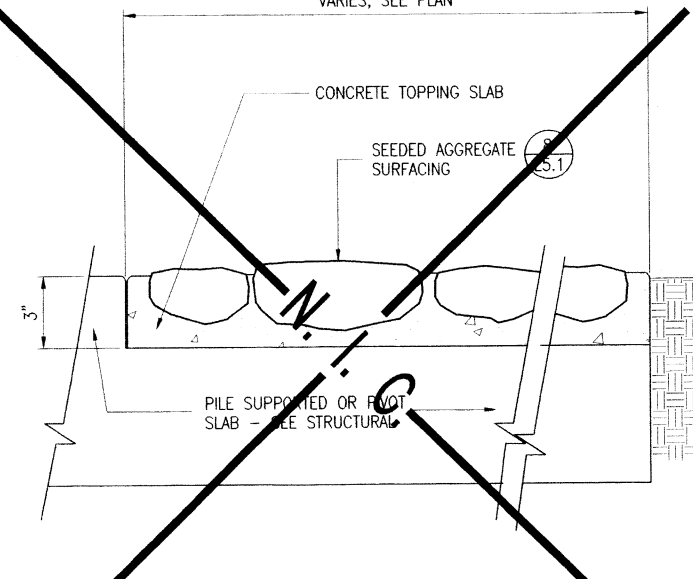


7 COBBLE PAVING @ STRUCTURAL SLAB  
SCALE: 1" = 3'-0"  
SECTION

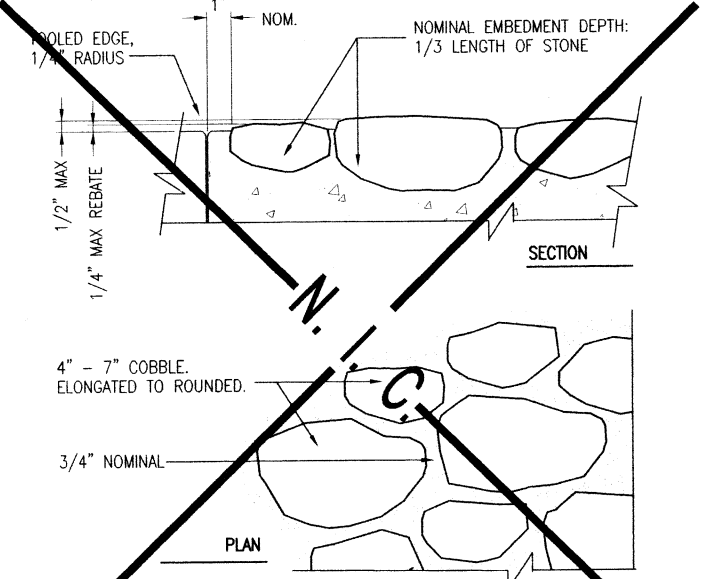


8 SEEDDED AGGREGATE SURFACING  
SCALE: 1" = 3'-0"  
SECTION

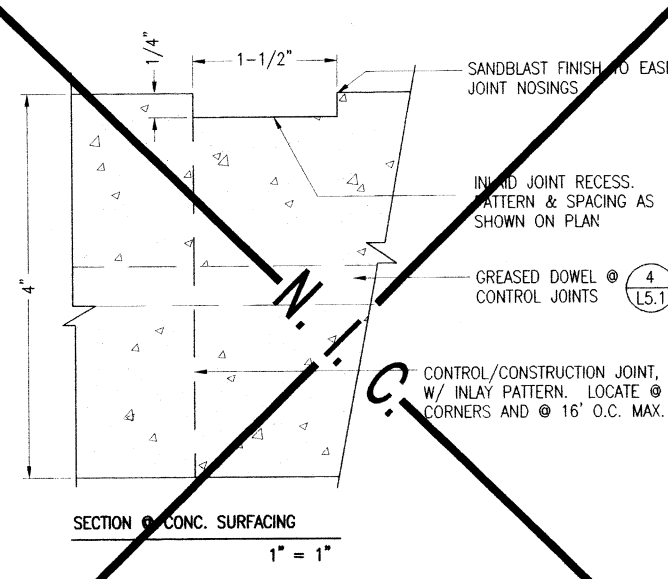


9 CONCRETE SURFACING JOINT DETAILS  
SCALE AS NOTED

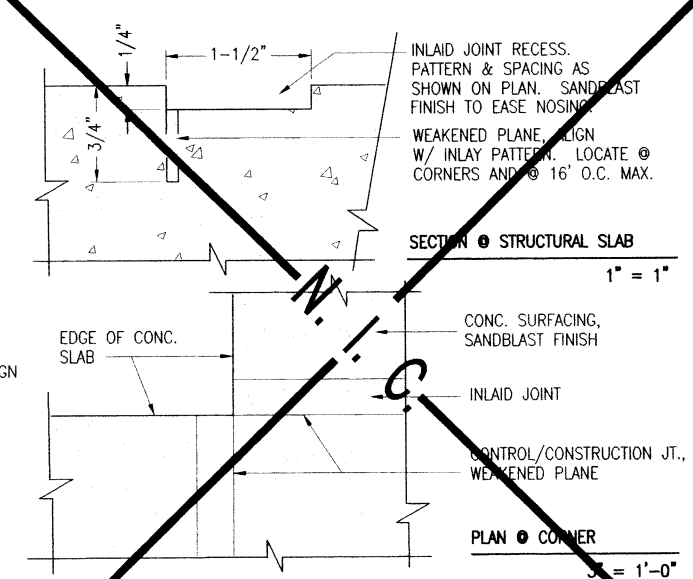


10 CONC. SURFACING W/ PLANTED JOINTS  
SCALE: 1" = 1'-0"  
TYP. SECTION

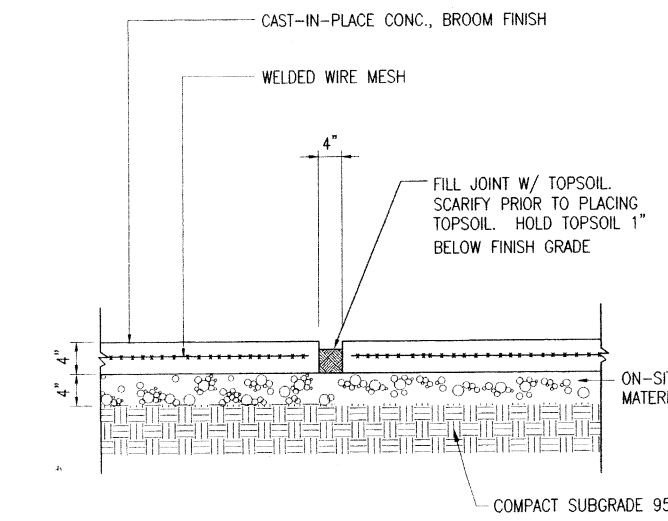


11 FLUSH COBBLE CURB  
SCALE: 1" = 1'-0"  
TYP. SECTION

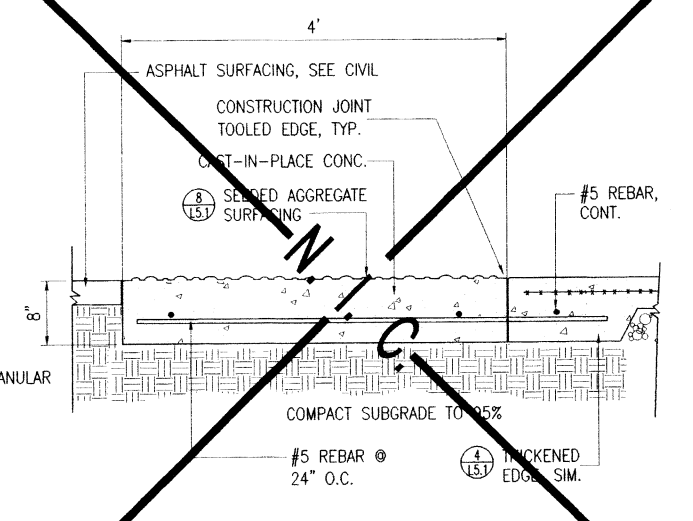


12 TRAFFIC ISLAND  
SCALE: 1" = 1'-0"  
TYP. SECTION

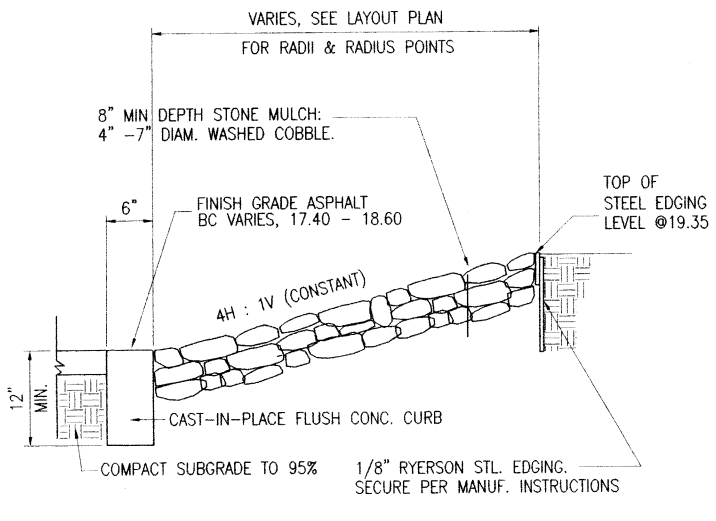


13 WOOD HEADER  
SCALE: 1" = 1'-0"  
TYP. SECTION

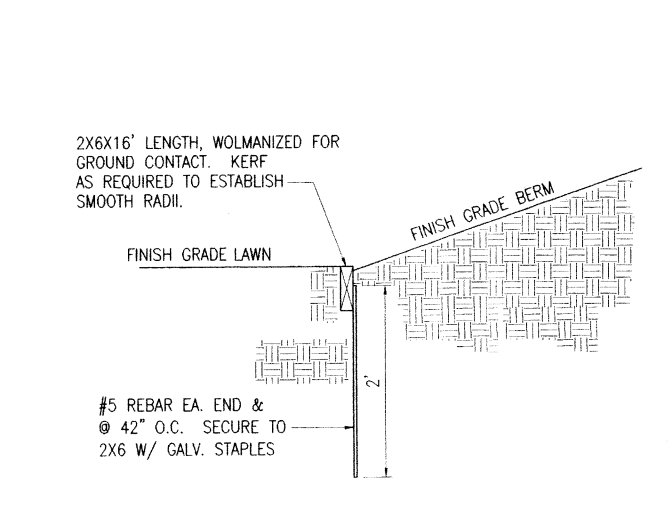


14 SANDSTONE CURB  
SCALE: AS NOTED  
TYP. SECTION

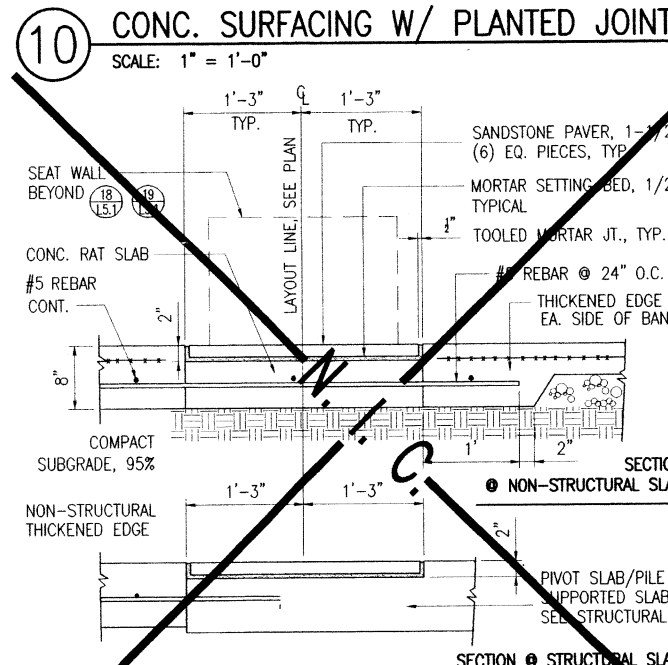


15 SANDSTONE BAND  
SCALE: 1" = 1'-0"  
SECTION @ STRUCTURAL SLAB

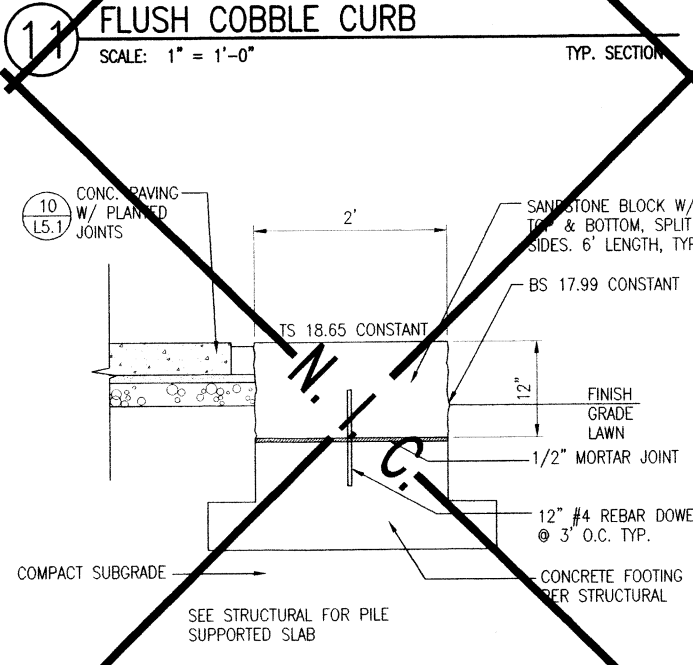


16 SANDSTONE STEP  
SCALE: 1" = 1'-0"  
TYP. SECTION

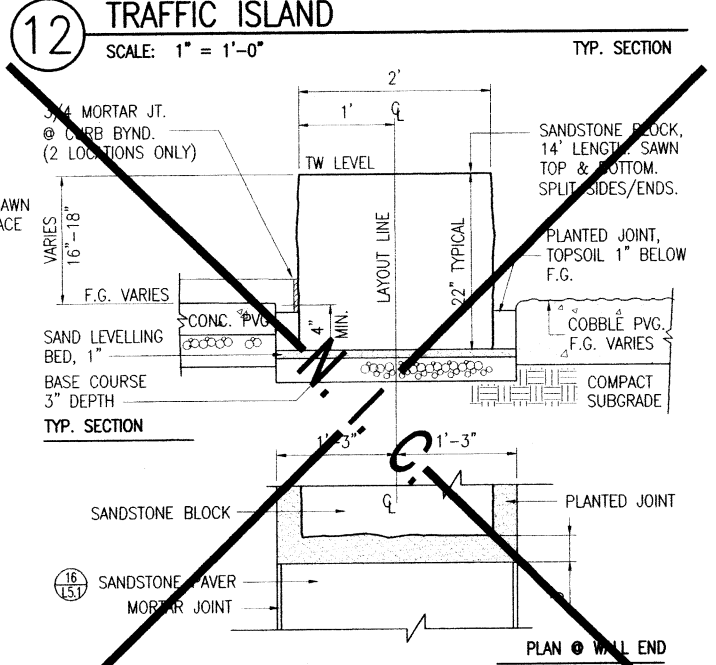

17 SANDSTONE SEAT WALL  
SCALE: 1" = 1'-0"  
PLAN @ WALL END

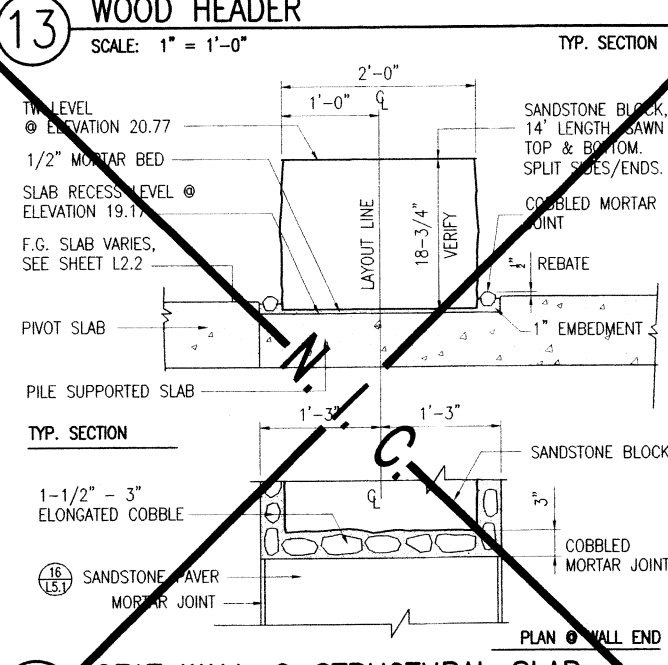


18 SANDSTONE SEAT WALL  
SCALE: 1" = 1'-0"  
TYP. SECTION

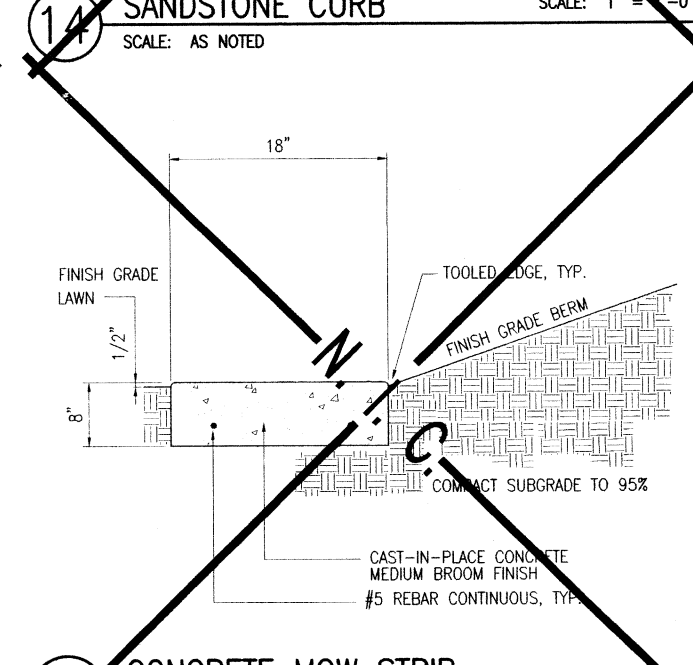

19 SEAT WALL @ STRUCTURAL SLAB  
SCALE: 1" = 1'-0"  
TYP. SECTION

NO.	DATE	REVISION

DR  
PARTNER IN CHARGE  
PROJECT MANAGER  
PROJECT ARCHITECT  
DR/AS  
DR/AS

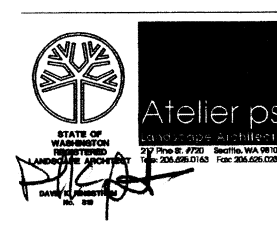

DETAILS

98060.00  
PROJECT NO.  
MAY 18, 1999  
DATE