


- Plan Notes:**
- SLAB ELEVATION SHALL BE AS NOTED ON PLAN. SLAB-ON-GRADE SHALL BE 2" THICK W/ REINFORCING AS NOTED ON PLAN, U.O.N. (SEE 4/53.2) PROVIDE 30 MIL VAPOR BARRIER BELOW SLAB AT INTERIOR SPACES. SEE ARCHITECTURAL DRAWINGS FOR SLAB DEPRESSION AND SLOPE REQUIREMENTS. PROVIDE FREE-DRAINING GRANULAR FILL PER SOILS REPORT.
  - FILES SHALL BE CENTERED ON COLUMN GRID LINES, U.O.N.
  - SEE 22/53.2 FOR TYPICAL FILE.
  - EXTERIOR METAL STUDS SHALL BE TYPE S-620 PER 30/51 U.O.N. WOOD STUD WALLS SHALL BE PER PLAN 4/5/56.1. SEE 30/56.1 FOR SPECIAL WOOD STUD REQUIREMENTS AT SHEAR WALL PANEL JOINTS.
  - HEADERS IN METAL STUD WALLS SHALL BE TYPE H-1 PER 6/51 U.O.N. HEADERS IN WOOD STUD WALLS SHALL BE PER 4/56.1 U.O.N.
  - ALL EXTERIOR WALLS SHALL BE SHEAR WALL TYPE 'SM-1' PER SCHEDULE OF 18/56.1 U.O.N.
  - JAMB STUDS AND POSTS SUPPORTING BEAMS OR HEADERS ABOVE SHALL BE (2) STUDS, U.O.N.
  - WHERE ADJACENT SHEAR WALLS ARE IN CONTACT, FASTEN STUDS TOGETHER PER 'FACE NAILING' COLUMN OF THE SHEAR WALL SCHEDULE OF 30/56.1 OR PER 'SCREWS TO WOOD BELOW' COLUMN OF 18/56.1.
  - THE SLAB IN THE COMMONS WING, EAST OF GRID 'CE' SHALL BE 8 1/2" THICK. THE TOP 1/2" WILL CONTAIN TOOLED JOINTS AND SHALL BE CONSIDERED NON-STRUCTURAL. SLAB TOP STEEL SHALL BE PLACED 1/2" CLEAR FROM THE TOP OF SLAB.
  - SEE ARCH. FOR SPECIAL FINISH REQUIREMENTS OF EXPOSED PLYWOOD SHEAR WALLS.

- Legend:**
- X-X TO SLAB ELEVATION
  - HOLD-DOWN MARK PER SCHEDULE OF 12/56.1
  - GB-1 GRADE BEAM PER 30/53.2
  - SM-X SHEAR WALL PER SCHEDULE OF 18/56.1 OR 30/56.1
  - S-6XX-XX METAL STUD FRAMING PER 30/51
  - M-2X WOOD STUD FRAMING PER 5/56.1
  - XX NUMBER OF STUDS IN MULTI-STUD POST
  - H-X HEADER (AND SILL WHERE OCCURS) ABOVE PER 6/51
  - (SQ.) SQUARE BASE PLATE - SEE DETAIL 2/53.1

- Bar Legend:**
- QUANTITY (WHERE SPECIFIED)
  - BAR SIZE
  - 'T' TOP, 'M' MIDDLE, OR 'B' BOTTOM
  - @ SPACING OR (EQ. SPACE IF NOT SPECIFIED)
  - (B) 5 B 15

**NOTE CHANGES:**

- FILES REMOVED ALONG GRID C3 AT GRIDS CA, CB, CC, CD, CE AND CF.
- FILE CAPS REMOVED. GRADE BEAMS WIDENED AS REQUIRED TO ENCASE PILES.
- REMOVED OIL/WATER SEPARATOR AT GRID CA5.
- ADDED SLAB, FOOTINGS AND/OR PILES FOR ENTRY, TRANSFORMER, RECEIVING, MECHANICAL UNIT AND STAIR #5.

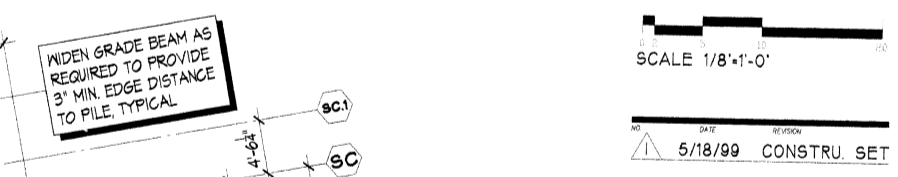

**SUN HEALTHCARE SYSTEMS, INC.**  
**CAMPUS: PHASE ONE**  
**ANACORTES, WASHINGTON**




SCALE 1/8"=1'-0"

5/18/99 CONSTRU. SET

JEC  
 BTL  
 CSD  
 HRB  
 JEC

COUGHLIN PORTER LUNDEEN  
 4000 15TH AVENUE, SUITE 300  
 SEATTLE, WA 98148

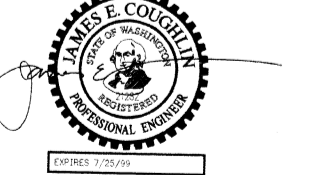

FOUNDATION  
 PLAN

98-0027-04  
 MAY 18, 1999

S2.1 CONSTRUCTION SET

PROJECT: SUN HEALTHCARE SYSTEMS, INC. CAMPUS: PHASE ONE, ANACORTES, WA  
 DATE: 5/18/99  
 DRAWN BY: JEC  
 CHECKED BY: BTL  
 PROJECT MANAGER: CSD  
 ARCHITECT: MARTHUN ARCHITECTURE  
 ENGINEER: COUGHLIN PORTER LUNDEEN