




SUN HEALTHCARE SYSTEMS, INC.
CAMPUS: PHASE ONE
ANACORTES, WASHINGTON

DATE: 5/18/99
 REVISION: CONSTRU. SET

JEC
 BTL
 CSD
 HRB
 JEC

COUGHLIN PORTER LUNDEEN
 A CORNERSTONE STRUCTURAL AND CIVIL ENGINEERING CORPORATION
 217 PINE STREET - SUITE 300
 SEATTLE, WA 98101

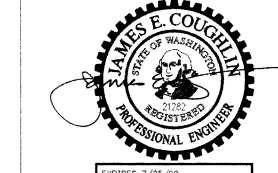

METAL FRAMING DETAILS
 98-0027-04
 MAY 18, 1999

S7.1 CONSTRUCTION SET

H-1

H-2

H-3

H-4

H-5

7

8

9

Project: SUN HEALTHCARE SYSTEMS, INC. 1000 1st Ave. New York, NY 10001
 Date: May 18, 1999 10:00 AM
 By: JEC
 Checked: JEC
 Scale: 1/8" = 1'-0"
 License No.: 12575