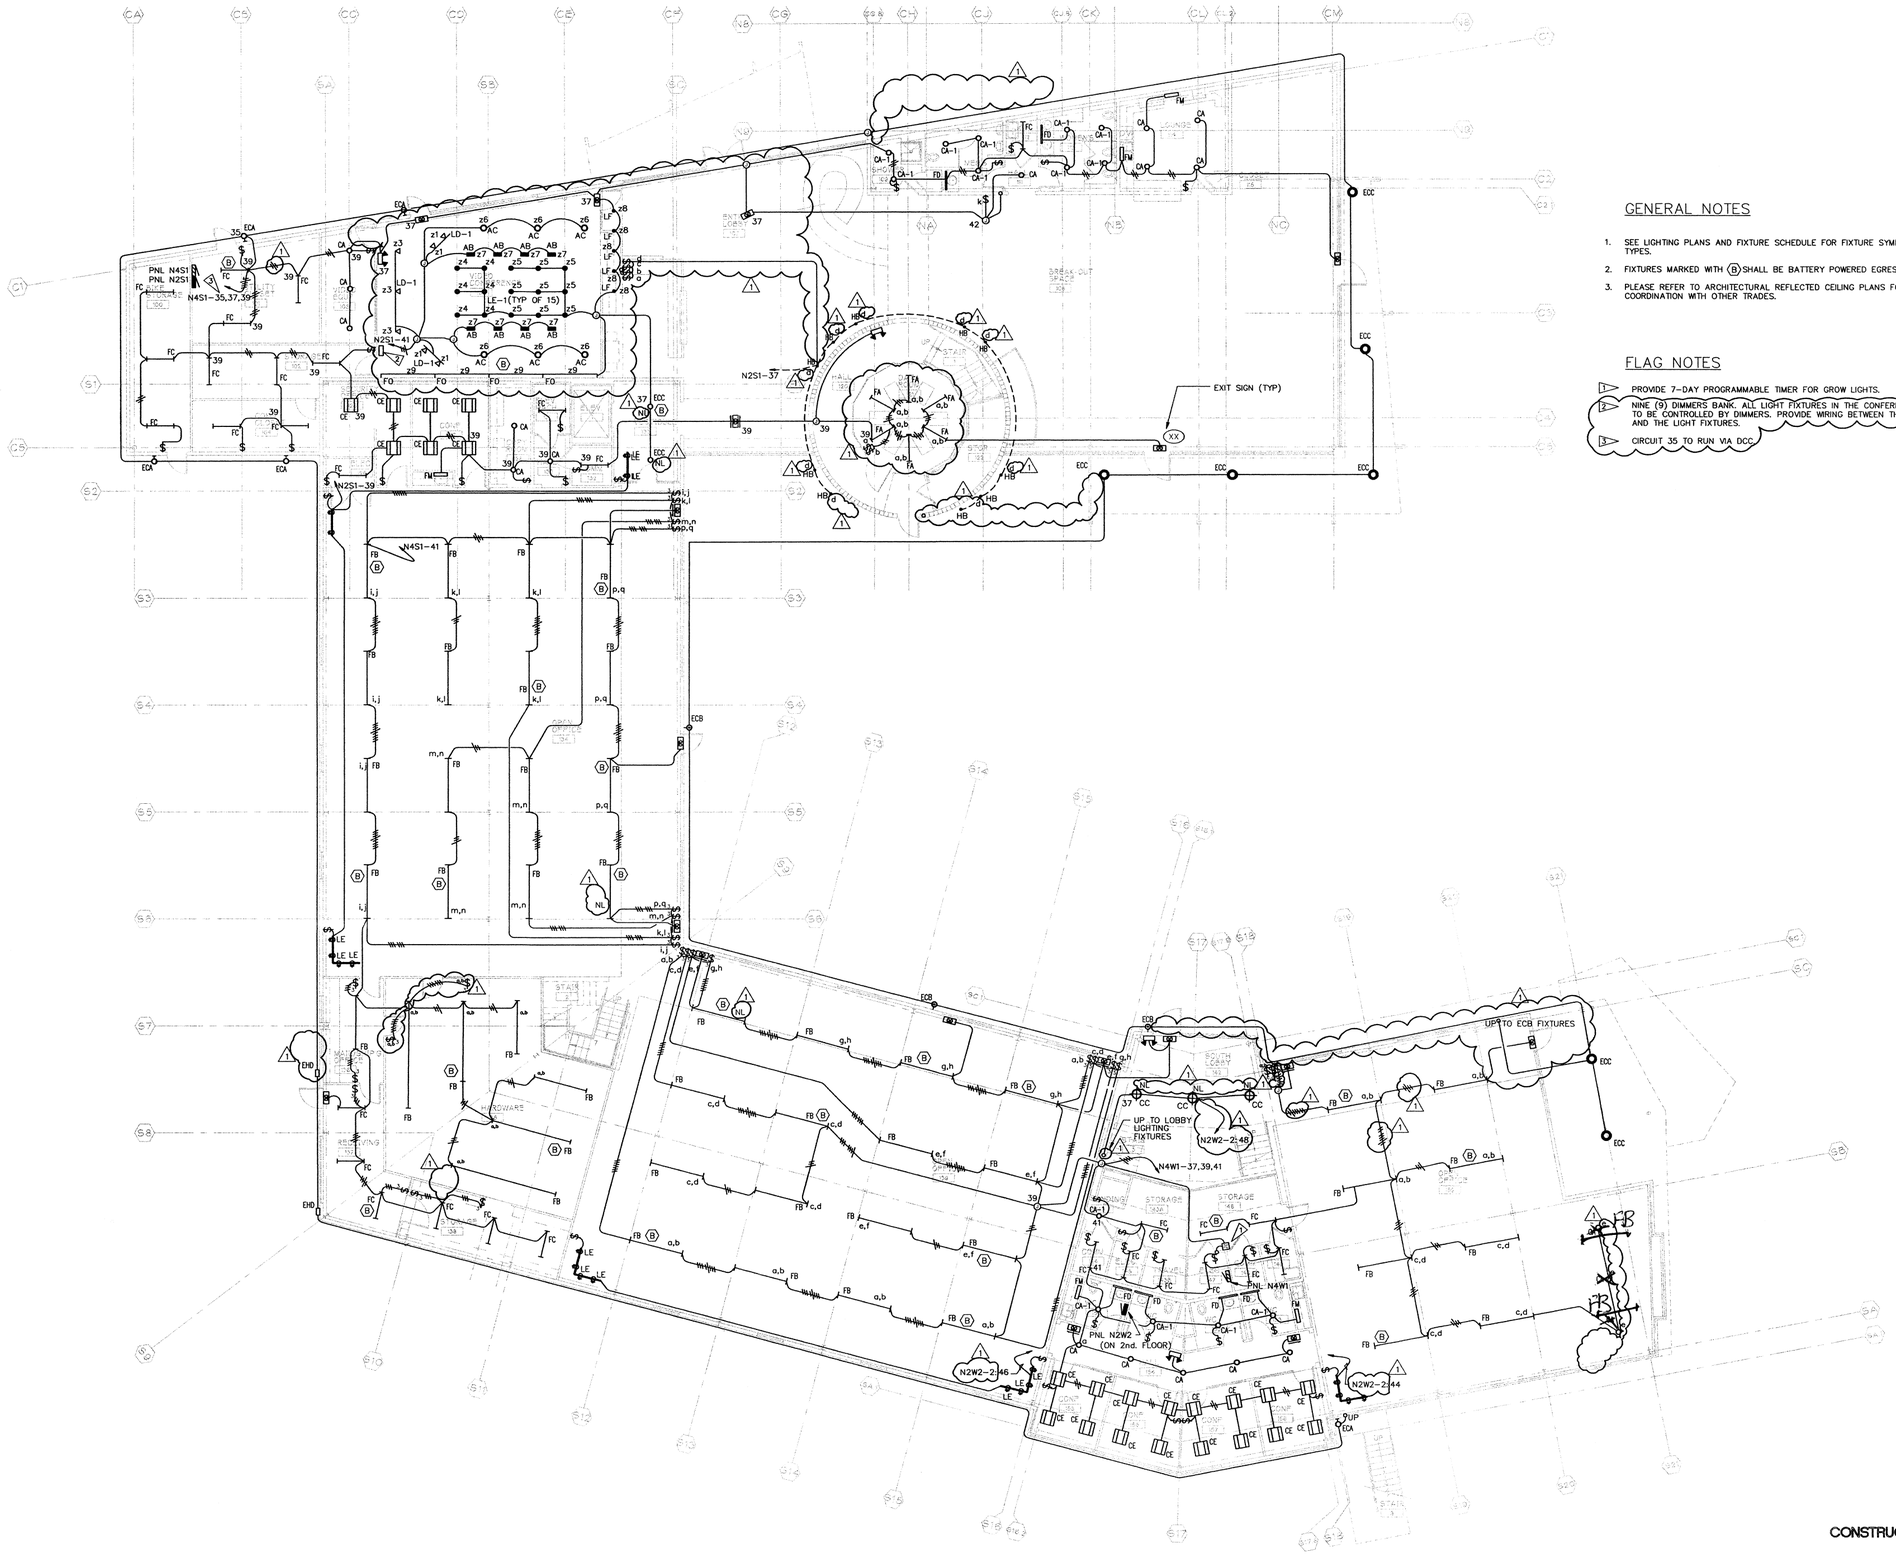

GENERAL NOTES

1. SEE LIGHTING PLANS AND FIXTURE SCHEDULE FOR FIXTURE SYMBOLS & TYPES.
2. FIXTURES MARKED WITH (B) SHALL BE BATTERY POWERED EGRESS FIXTURES.
3. PLEASE REFER TO ARCHITECTURAL REFLECTED CEILING PLANS FOR COORDINATION WITH OTHER TRADES.

FLAG NOTES

1. PROVIDE 7-DAY PROGRAMMABLE TIMER FOR GROW LIGHTS.
2. NINE (9) DIMMERS BANK. ALL LIGHT FIXTURES IN THE CONFERENCE ROOM TO BE CONTROLLED BY DIMMERS. PROVIDE WIRING BETWEEN THE DIMMERS AND THE LIGHT FIXTURES.
3. CIRCUIT 35 TO RUN VIA DCC.

MITHUN PARTNERS
ARCHITECTURE PLANNING & INTERIOR DESIGN
414 OLIVE WAY SUITE 500 SEATTLE WA 98101 (206) 623 3344 FAX (206) 623 7085

SPARLING
ELECTRICAL ENGINEERING, LIGHTING DESIGN & TECHNOLOGY CONSULTING
720 OLIVE WAY - SUITE 1100
SEATTLE, WA 98101-1853
FAX 206-667-0554
PHONE 206-667-0555

SUN HEALTHCARE SYSTEMS, INC.
CAMPUS: PHASE ONE
ANACORTES, WASHINGTON

TRUE NORTH

SCALE 1/8"=1'-0"

NO.	DATE	REVISION
1	5/18/99	CONST. SET

DOUG BORS
PRINCIPAL IN CHARGE
BILL VAN VLACK, PE
PROJECT MANAGER
ED SANTOS
PROJECT DESIGNER
DRAWN
CHECK

WILLIAM VAN VLACK
STATE OF WASHINGTON
23039
REGISTERED PROFESSIONAL ENGINEER
EXPIRES 12-17-2000

TITLE
LIGHTING PLAN
FIRST FLOOR

98060
MITHUN PROJECT NO.
FEBRUARY 9, 1999
DATE
7651
SPARLING PROJECT NO.
1/8" = 1'-0"
SCALE

CONSTRUCTION SET

E3.1
SHEET NUMBER

COPYRIGHT © 1998 MITHUN PARTNERS, INC.

051899

J:\7651\REDESIGN\CADD\E3.1.DWG MAY 18, 1999 - 10:52:54 AM BY: LAS