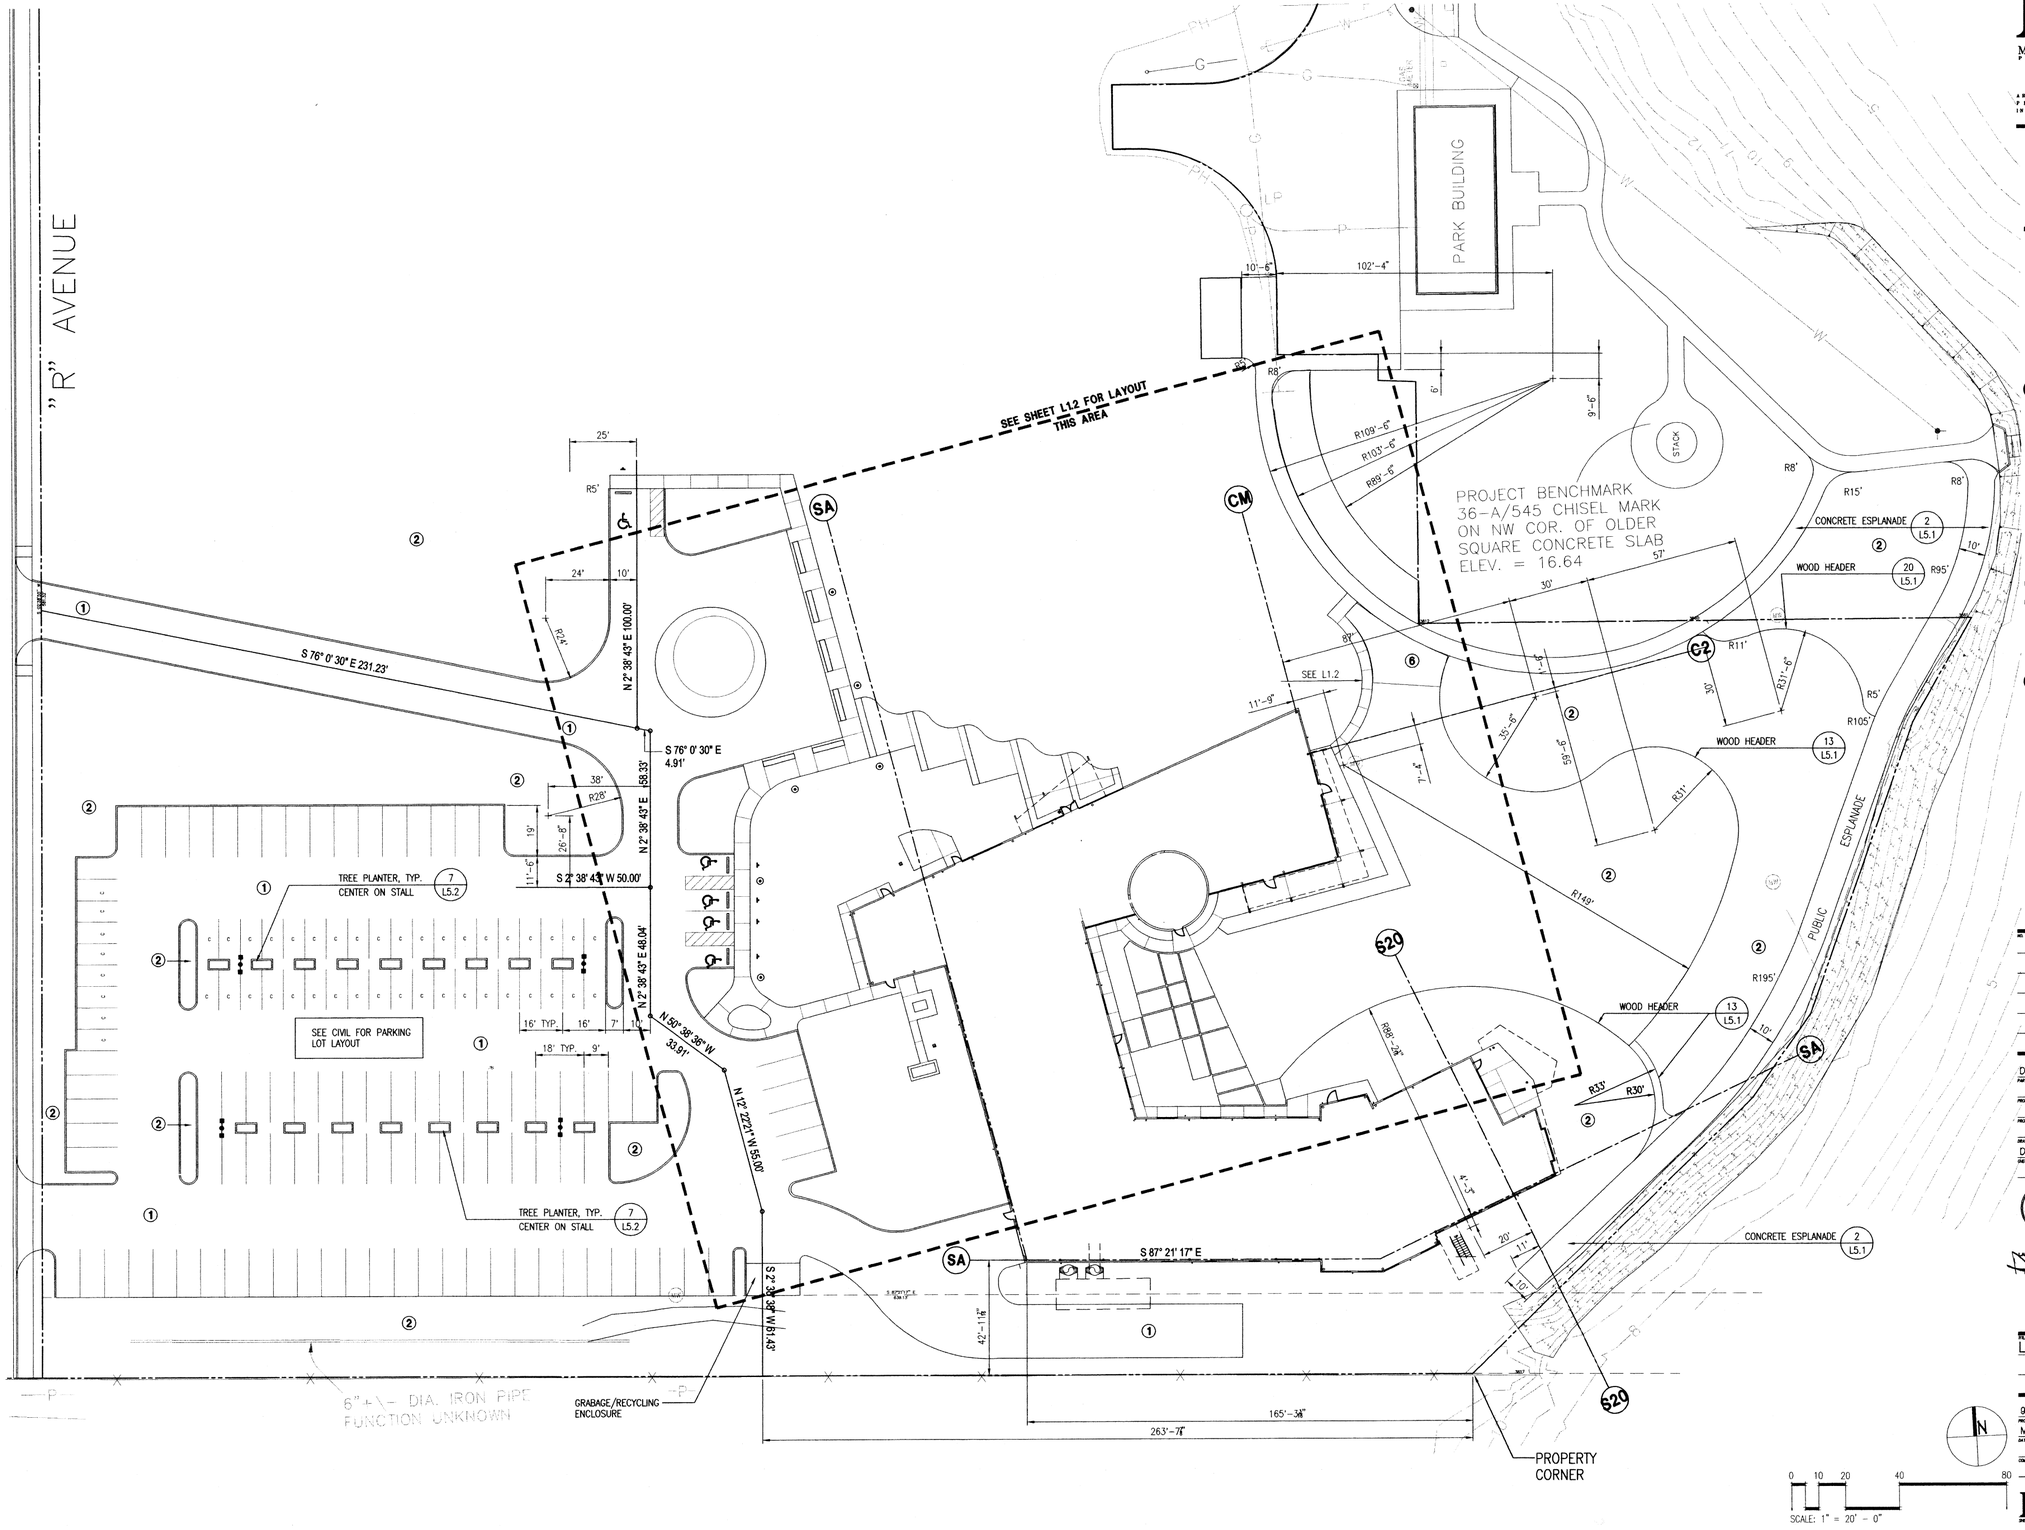

MITHUN PARTNERS
ARCHITECTURE PLANNING & INTERIOR DESIGN
414 OLIVE WAY SUITE 800 SEATTLE WA 98101 (206) 623 3344 FAX (206) 623 7405


CAMPUS: PHASE ONE
ANACORTES, WASHINGTON

NO.	DATE	REVISION

DR
PARTNER IN CHARGE

PROJECT MANAGER

PROJECT ARCHITECT

DR/AS
DRAWN

INDEX

STATE OF WASHINGTON
REGISTERED LANDSCAPE ARCHITECT

Atelier ps
217 Pine St. #700 Seattle, WA 98101
Tel: 206.624.5670 Fax: 206.624.3306

FILE
LAYOUT PLAN

98060.00
PROJECT NO.

MAY 18, 1999
DATE

COMPUTER FILE NAME

L1.1
SHEET NUMBER

CONSTRUCTION SET

COPYRIGHT © 1999 MITHUN PARTNERS, INC.